

Harrison  
H 72  
8-67

MISSISSIPPI  
 BOARD OF WATER COMMISSIONERS  
 416 North State Street  
 Jackson, Mississippi 39201

**CODED**

WATER WELL DRILLERS LOG

August 27, 1967 19  
 date well completed

R. J. Moore  
 firm name

Harrison County  
 county well located

LANDOWNER: Walter M. Krohn  
Rt 2 Box 283  
Biloxi, Miss  
 (mailing address)

description of formations encountered	from	to
<u>Top soil</u>	<u>0</u>	<u>10</u>
<u>Red Sand</u>	<u>10</u>	<u>88</u>
<u>White Clay</u>	<u>88</u>	<u>135</u>
<u>White Sand &amp; Gravel</u>	<u>135</u>	<u>152</u>
<u>Blue Clay</u>	<u>152</u>	<u>167</u>
<u>White Sand</u>	<u>167</u>	<u>177</u>
<u>Blue Clay</u>	<u>177</u>	<u>291</u>
<u>Blue Sand (coarse)</u>	<u>291</u>	<u>325</u>

WELL LOCATION:  
 sec. 24 T. 6 N. R. 10 E.  
8 miles east of Biloxi  
 (distance) (direction) (nearest town)

WELL PURPOSE: home  
 (home, irrigation, municipal, industrial)

WELL COMPLETION DATA:


- (1) diameter (inches) 2"
- (2) total depth (feet) 325'
- (3) static water level (feet) 40 <sup>below</sup>/<sub>above</sub> top of ground.
- (4) casing 2" galv, 315'  
 (material) (depth)
- (5) screen 10', 315'  
 (length) (depth to top)  
2", Stainless Steel  
 (size) (material)
- (6) pump 1hp, 100gpm  
 (HP) (yield gpm)  
electric  
 (type power)
- (7) electric log NO  
 (yes or no)

(organization running log)

(8) how well bottom plugged back  
wash valve


DRILLERS REMARKS:

**CODED**

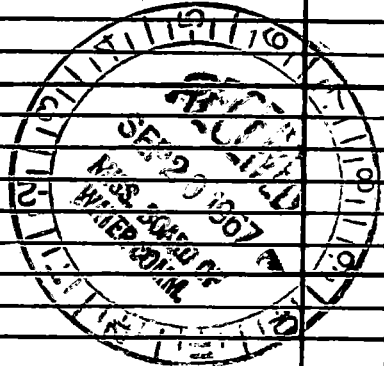

If well telescopes please sketch and show depths.

GROUND LEVEL

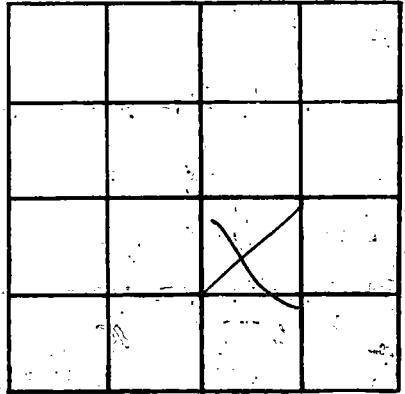

SECTION 24

Please indicate well location X.

ADDITIONAL INFORMATION

If more than one screen, show locations of each on sketch.