

Harrison  
H 73  
8-67

MISSISSIPPI  
BOARD OF WATER COMMISSIONERS  
416 North State Street  
Jackson, Mississippi 39201

**CODED**

WATER WELL DRILLERS LOG

8-30 1967 date well completed  
Switzer Well Co. firm name  
Harrison county well located

LANDOWNER: P. D. Legg

description of formations encountered

from to

Spate 1 Box 733  
Sucier Miss.  
(mailing address)

description of formations encountered	from	to
Clay	0	10
sand	10	22
fine sand	22	43
good sand	43	64
hard + clay strks	64	84
clay	84	168
sand + clay strks	168	229
clay	229	239
fine sand	239	247
fair sand	247	269
good sand	269	282

WELL LOCATION:

sec. 32 T. 6 S. R. 10 W.  
2 miles NW of WOOD MARK  
(distance) (direction) (nearest town)

WELL PURPOSE: Home  
(home, irrigation, municipal, industrial)


WELL COMPLETION DATA:

- (1) diameter (inches) 2
  - (2) total depth (feet) 283
  - (3) static water level (feet) 7' below  
top of ground.
  - (4) casing gal steel, 272 3/4"  
(material) (depth)  
2" if telescope see back.  
(size)
  - (5) screen 10' 1 1/4", 272 3/4"  
(length) (depth to top)  
brass - Clayton Mark  
(size) (material) Screen
  - (6) pump not installed  
(HP) (yield gpm)
  - (7) electric log No  
(yes or no)
- (organization running log)

(8) how well bottom plugged Back  
pressure valve

DRILLERS REMARKS:

**CODED**

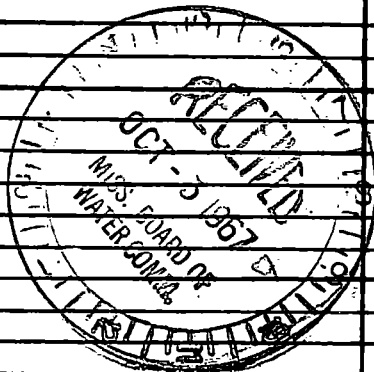

If well telescopes please sketch and show depths.

*10/1/10*

GROUND LEVEL

*Handwritten notes and sketches in the vertical column, including a large sketch of a well structure.*

			X

SECTION 32

Please indicate well location X.

ADDITIONAL INFORMATION

*Multiple horizontal lines for additional information, with some faint handwritten notes.*

If more than one screen, show locations of each on sketch.