

Harrison
H 74
8-67

MISSISSIPPI
BOARD OF WATER COMMISSIONERS
416 North State Street
Jackson, Mississippi 39201

CODED

WATER WELL DRILLERS LOG

Aug. 22 1967 Coast Water Well Service HARRISON
date well completed firm name county well located

LANDOWNER: Mike Verker
Box 258A
Biloxi Miss
(mailing address)

WELL LOCATION:
sec 32 T 6 N R 9 E
8 miles North of Biloxi
(distance) (direction) (nearest town)

description of formations encountered	from	to
Red clay	0	10
Coarse Pink Sand	10	53
Blue Clay	53	126
Sandy Shale	126	147
Blue Clay	147	336
Medium to Coarse Sand	336	357

WELL PURPOSE: Home
(home, irrigation, municipal, industrial)

WELL COMPLETION DATA:

(1) diameter (inches) Two

(2) total depth (feet) 357

(3) static water level (feet) 70 below top of ground.

(4) casing Clav. 367
(material) (depth)
Two If telescope see back.
(size)


(5) screen 10 ft. 367
(length) (depth to top)
10 slot Plastic
(size) (material)

(6) pump One 9
(HP) (yield gpm)
Elect.
(type power)

(7) electric log no
(yes or no)
N. A.
(organization running log)

(8) how well bottom plugged
Backwash valve

CODED

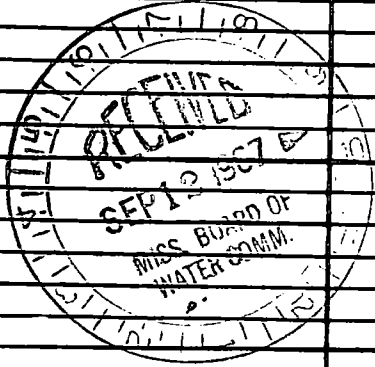


DRILLERS REMARKS:

If well telescopes please sketch and show depths.

32

GROUND LEVEL

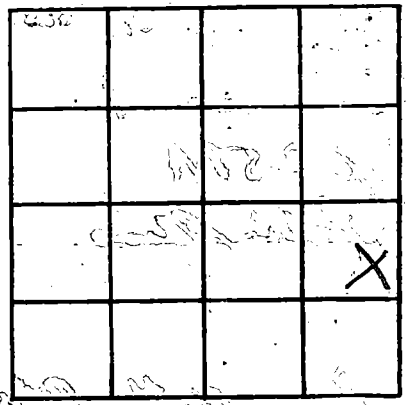

SECTION *32*

Please indicate well location X.

ADDITIONAL INFORMATION

If more than one screen, show locations of each on sketch.