

1/2 mi. S. Highway 67

Harrison  
H 75  
9-67

MISSISSIPPI  
BOARD OF WATER COMMISSIONERS  
416 North State Street  
Jackson, Mississippi 39201

**CODED**

WATER WELL DRILLERS LOG

9-1 1967 Switzer Well Co. Harrison  
date well completed firm name county well located

LANDOWNER: Carl Taylor  
John Lee Road -  
Gulfport, Miss  
(mailing address)

WELL LOCATION:  
sec. 16 T 6 N R 10 W  
6 miles N of WOOD MARKET  
(distance) (direction) (nearest town)


WELL PURPOSE: Home  
(home, irrigation, municipal, industrial)

WELL COMPLETION DATA:

- (1) diameter (inches) 2
- (2) total depth (feet) 473
- (3) static water level (feet) 79 below top of ground
- (4) casing gal. steel, 463' (material) (depth)  
2" If telescope see back. (size)
- (5) screen 10' , 463' (length) (depth to top)  
800 , 55 on pipe (size) (material)
- (6) pump 1 (HP) 7 (yield gpm)  
electric (type power)
- (7) electric log Yes (yes or no)
- (organization running log)
- (8) how well bottom plugged Back pressure valves

description of formations encountered	from	to
clay + sand strks	0	22
clay	22	64
clay + sand strks	64	106
fine sand	106	136
clay	136	183
clay + sand strks	183	225
clay	225	246
clay + sand strks	246	309
clay	309	351
clay + sand strks	351	410
fair sand	410	430
good sand	430	471

**CODED**

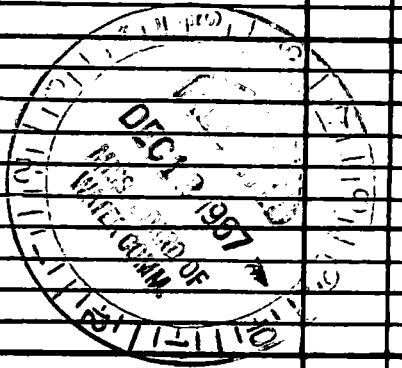

DRILLERS REMARKS:

If well telescopes please sketch and show depths.

GROUND LEVEL

			X

SECTION 16

Please indicate well location X.

**ADDITIONAL INFORMATION**

If more than one screen, show locations of each on sketch.