

Harrison  
H 76  
10-67

MISSISSIPPI  
BOARD OF WATER COMMISSIONERS  
416 North State Street  
Jackson, Mississippi 39201  
WATER WELL DRILLERS LOG

**CODED**

10-25 1967 date well completed  
Switzer Well Co. firm name  
Harrison county well located

LANDOWNER: Walter Husley  
Route 1 Box 554  
Biloxi Miss.  
(mailing address)

WELL LOCATION:  
sec 36 T 6 S R 10 W  
3 miles E of WOOL MARKET  
(distance) (direction) (nearest town)


WELL PURPOSE: Home  
(home, irrigation, municipal, industrial)

WELL COMPLETION DATA:

- (1) diameter (inches) 2
- (2) total depth (feet) 469
- (3) static water level (feet) 4 below top of ground
- (4) casing gal steel 459' (material) (depth)  
2" (size) if telescope see back.
- (5) screen 10' 459' (length) (depth to top)  
8 ga. SS on pipe (size) (material)
- (6) pump not installed (HP) (yield gpm)
- (type power)
- (7) electric log No (yes or no)
- (organization running log)
- (8) how well bottom plugged Back pressure valve

description of formations encountered	from to	
clay	0	22
fine sand	22	42
sand	42	60
fine clay	60	63
clay + sand streaks	63	102
clay	102	145
clay + sand streaks	145	166
fine sand	166	187
sand	187	192
fine clay	192	208
clay + sand streaks	208	229
sand	229	239
fine clay	239	250
clay + sand streaks	250	292
clay	292	329
clay + sand streaks	329	376
clay	370	386
fine sand	386	390
clay + sand streaks	390	411
fine sand	411	433
good sand	433	472


**CODED**

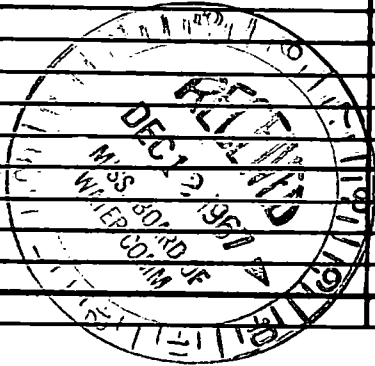

DRILLERS REMARKS:

If well telescopes please sketch and show depths.

GROUND LEVEL

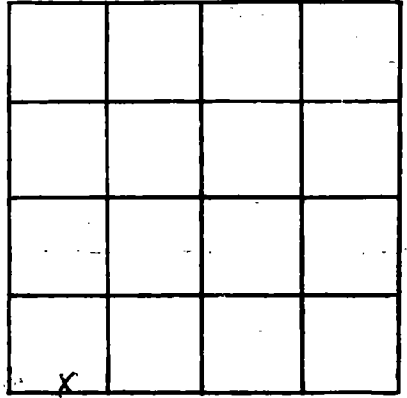

SECTION 36

Please indicate well location X.

ADDITIONAL INFORMATION

If more than one screen, show locations of each on sketch.