

15, 1910 miles after you turn off Hwy 67.

Harrison  
H 78  
11-67

MISSISSIPPI  
BOARD OF WATER COMMISSIONERS  
416 North State Street  
Jackson, Mississippi 39201

**CODED**

WATER WELL DRILLERS LOG

11-30 1967 date well completed  
Switzer Well Co. firm name  
Harrison county well located

LANDOWNER: Joe Seidule  
Route 2 Box 309  
Biloxi, Miss.  
(mailing address)

WELL LOCATION:  
sec. 29 T. 6 S. R. 9 E  
8 miles N of BILOXI  
(distance) (direction) (nearest town)


WELL PURPOSE: Home  
(home, irrigation, municipal, industrial)

WELL COMPLETION DATA:

- (1) diameter (inches) 2
- (2) total depth (feet) 488
- (3) static water level (feet) 11 above top of ground.
- (4) casing gal. steel 478' (material) (depth)  
2" If telescope see back. (size)
- (5) screen 10' 478' (length) (depth to top)  
8 ga. SS on pipe (size) (material)
- (6) pump not installed (HP) (yield gpm)  
electric (type power)
- (7) electric log No (yes or no)  
(organization running log)
- (8) how well bottom plugged Back pressure valve

description of formations encountered	from	to
clay	0	18
sand	18	40
fine clay	40	43
clay	43	64
clay + sand streaks	64	85
clay	85	106
clay + sand streaks	106	168
clay	168	180
fine sand	180	188
sand	188	200
fine clay	200	206
sand	206	208
clay	208	273
fine sand	273	290
fine clay	290	310
clay + sand streaks	310	352
clay	352	373
clay + sand streaks	373	433
fine sand	433	455
good sand	455	492


**CODED**

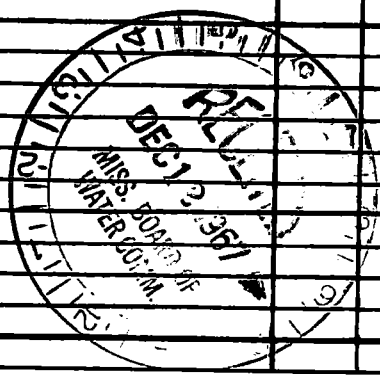

DRILLERS REMARKS:

If well telescopes please sketch and show depths.

GROUND LEVEL

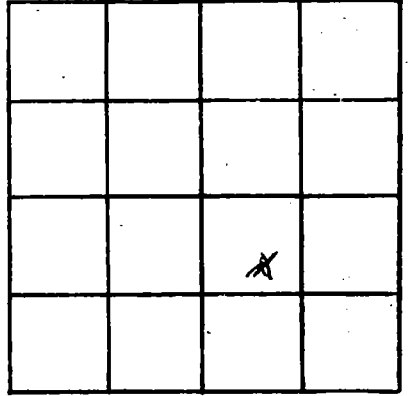

SECTION 29

Please indicate well location X.

ADDITIONAL INFORMATION

If more than one screen, show locations of each on sketch.