

HARRISON
H 79
2-68

MISSISSIPPI
BOARD OF WATER COMMISSIONERS
416 North State Street
Jackson, Mississippi 39201

WATER WELL DRILLERS LOG

CODED

9/19 1968 Switzer Well Co. Harrison
date well completed firm name county well located

LANDOWNER: Mrs. Bill Fraser

description of formations encountered	from	to
clay w/sand streaks	0	22
clay	22	42
clay w/sand streaks	42	63
fine sand	63	104
good sand	104	119
clay	119	125
clay w/sand streaks	125	146
clay	146	167
clay w/sand streaks	167	187
clay	187	226
clay w/sand streaks	226	308
clay	308	348
clay w/sand streaks	348	388
fair sand	388	408
good sand	408	464

Route 1 Box 566 1/2
Beloxi Miss 39532
(mailing address)

WELL LOCATION:
sec 35 T 6 R 10
S W
3 miles E of WOOD MARKET
(distance) (direction) (nearest town)

WELL PURPOSE: Home
(home, irrigation, municipal, industrial)

WELL COMPLETION DATA:


- (1) diameter (inches) 2
- (2) total depth (feet) 449
- (3) static water level (feet) 14 below above top of ground.
- (4) casing gal steel, 439'
(material) (depth)
2" if telescope see back.
(size)
- (5) screen 10', 439'
(length) (depth to top)
8 ga, SS on pipe
(size) (material)
- (6) pump 3/4, 600
(HP) (yield gpm)
electric
(type power)
- (7) electric log No
(yes or no)

(organization running log)

(8) how well bottom plugged Back pressure valve


DRILLERS REMARKS:

CODED

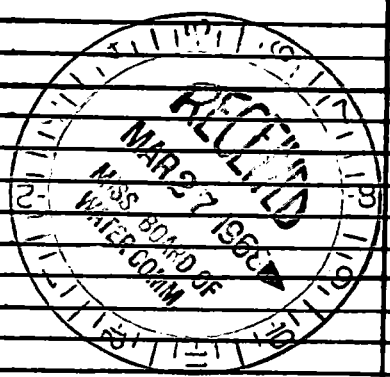

If well telescopes please sketch and show depths.

GROUND LEVEL

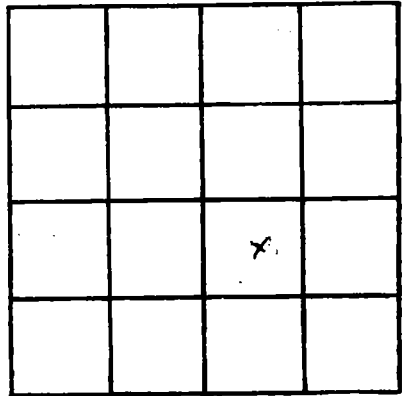

SECTION 35

Please indicate well location X.

ADDITIONAL INFORMATION

If more than one screen, show locations of each on sketch.