

Harrison  
H 82  
1-68

MISSISSIPPI  
 BOARD OF WATER COMMISSIONERS  
 416 North State Street  
 Jackson, Mississippi 39201

**CODED**

**CODED**

WATER WELL DRILLERS LOG

Jan 24 1968 Ladwin's Well Works Harrison  
 date well completed firm name county well located

LANDOWNER: Mrs. Walter  
Woolmarket  
 (mailing address)

description of formations encountered	from	to
<u>Red Sand &amp; Clay</u>	<u>0</u>	<u>120</u>
<u>Blue Clay</u>	<u>120</u>	<u>175</u>
<u>Sand</u>	<u>30 feet</u>	


WELL LOCATION:  
 sec. 33 T 6 N R 10 E  
1 miles South of Woolmarket  
 (distance) (direction) (nearest town)

WELL PURPOSE: Home  
 (home, irrigation, municipal, industrial)

**CODED**

- WELL COMPLETION DATA:
- (1) diameter (inches) 2 inch
  - (2) total depth (feet) 485
  - (3) static water level (feet) 440 <sup>below</sup> top of ground.
  - (4) casing 2 inch 475  
 (material) (depth)  
2 inch if telescope see back.  
 (size)
  - (5) screen 10 475  
 (length) (depth to top)  
008 Stainless Steel  
 (size) (material)
  - (6) pump 1/2 12  
 (HP) (yield gpm)  
Elec.  
 (type power)
  - (7) electric log no  
 (yes or no)
- (organization running log)
- (8) how well bottom plugged Back  
Utah Valve

DRILLERS REMARKS:

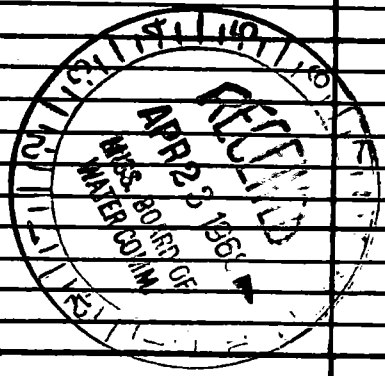

If well telescopes please sketch and show depths.

GROUND LEVEL

			X

SECTION 33

Please indicate well location X.

ADDITIONAL INFORMATION

If more than one screen, show locations of each on sketch.