

Harrison
H 83
2-68 **CODED**

MISSISSIPPI
 BOARD OF WATER COMMISSIONERS
 416 North State Street
 Jackson, Mississippi 39201

CODED

WATER WELL DRILLERS LOG

Feb. 1 1968 Ladner's Well Works Harrison
 date well completed firm name county well located


LANDOWNER: <u>Mr Husley</u>	description of formations encountered	from	to
<u>Woolmarket, Miss</u> (mailing address)			
	<u>Red sand & clay</u>	<u>0</u>	<u>122</u>
	<u>Blue clay & sand</u>	<u>122</u>	<u>315</u>

WELL LOCATION:
 sec. 33T-6N R. 10E
2 miles South East of Woolmarket
 (distance) (direction) (nearest town)

WELL PURPOSE: home
 (home, irrigation, municipal, industrial)

- WELL COMPLETION DATA:
- (1) diameter (inches) 2 inch
 - (2) total depth (feet) 315
 - (3) static water level (feet) 18 below above top of ground.
 - (4) casing 2 inch, 305,
 (material) (depth)
2 inch if telescope see back.
 (size)
 - (5) screen 10, 305
 (length) (depth to top)
008, Stainless Steel
 (size) (material)
 - (6) pump 1, 20
 (HP) (yield gpm)
Elec
 (type power)
 - (7) electric log No
 (yes or no)
- (organization running log) _____
- (8) how well bottom plugged Back
Wash Valve


CODED

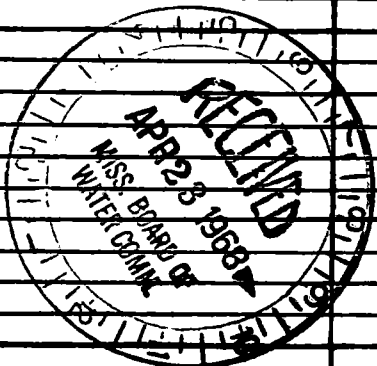

DRILLERS REMARKS: _____

If well telescopes please sketch and show depths.

GROUND LEVEL

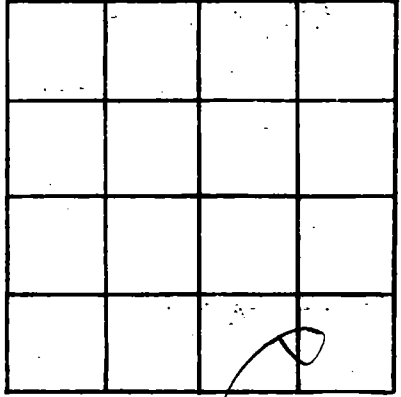

SECTION 33

Please indicate well location X.

ADDITIONAL INFORMATION

If more than one screen, show locations of each on sketch.