

Harrison
 R 87
 P-68

MISSISSIPPI
 BOARD OF WATER COMMISSIONERS
 416 North State Street
 Jackson, Mississippi 39201

CODED

WATER WELL DRILLERS LOG

Aug 1968 Coastal Drilling Harrison
 date well completed firm name county well located

LANDOWNER: Edward Trochenet
Rt 1 #4743 Bilal, Miss
 (mailing address)

description of formations encountered	from	to
gravel	1	22
white sand	22	37
gravel	37	50
loam	50	60
Baker sand	60	120
Very fine Baker clay	120	240
fine sand	240	257
Baker clay	257	260
fine sand	260	280
Very coarse sand	280	295

WELL LOCATION:
 sec 29 T 6 N R 10
1/2 miles # of Woodman
 (distance) (direction) (nearest town)

WELL PURPOSE: home
 (home, irrigation, municipal, industrial)

WELL COMPLETION DATA:

(1) diameter (inches) 2'

(2) total depth (feet) 295

(3) static water level (feet) _____ below above top of ground.

(4) casing galv 295'
 (material) (depth)
 _____ if telescope see back.
 (size)

(5) screen 10' _____
 (length) (depth to top)
2 SS
 (size) (material)

(6) pump _____
 (HP) (yield gpm)

 (type power)

(7) electric log _____
 (yes or no)

 (organization running log)

(8) how well bottom plugged good

CODED


DEC 10 1968

DRILLERS REMARKS:

MISS. BD OF
 WATER COMMISSIONERS

If well telescopes please sketch and show depths.

GROUND LEVEL

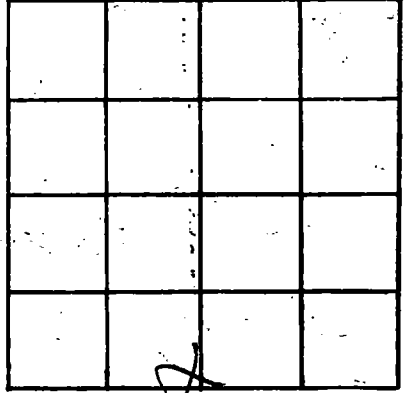

SECTION _____

Please indicate well location X.

ADDITIONAL INFORMATION

If more than one screen, show locations of each on sketch.