

CODED

MISSISSIPPI
BOARD OF WATER COMMISSIONERS
416 North State Street
Jackson, Mississippi 39201

WATER WELL DRILLERS LOG

Harrison
H 88
11-68

Nov 1968 date well completed
Ed Coastal Drilling firm name
Harris county well located

LANDOWNER:
F. Bayette
Rt 1 Box 806 Biloxi, Miss
(mailing address)

| description of formations encountered | from | to |
|---------------------------------------|------------|------------|
| <u>pipe clay</u> | <u>1</u> | <u>36</u> |
| <u>white sand</u> | <u>36</u> | <u>47</u> |
| <u>pipe clay</u> | <u>47</u> | <u>68</u> |
| <u>Blue Clay</u> | <u>68</u> | <u>239</u> |
| <u>very fine blue sand</u> | <u>239</u> | <u>250</u> |
| <u>hard blue sand</u> | <u>250</u> | <u>323</u> |
| <u>Coarse sand</u> | <u>323</u> | <u>336</u> |

WELL LOCATION:
sec 27 T 6 N R 10 E
S W
9 miles N of Yat
(distance) (direction) (nearest town)

WELL PURPOSE:
home
(home, irrigation, municipal, industrial)

WELL COMPLETION DATA:
(1) diameter (inches) 2"
(2) total depth (feet) 336
(3) static water level (feet) _____ below above top of ground.
(4) casing 2" 336'
(material) (depth)
(size) if telescope see back.
(5) screen 10' 326'
(length) (depth to top)
2" 58
(size) (material)
(6) pump 1 16
(HP) (yield gpm)
Elk
(type power)
(7) electric log _____
(yes or no)
(organization running log)
(8) how well bottom plugged good

CODED

DEC 16 1968


DRILLERS REMARKS:

MISS. BOARD OF WATER COMMISSIONERS

00013

If well telescopes please sketch and show depths.

GROUND LEVEL

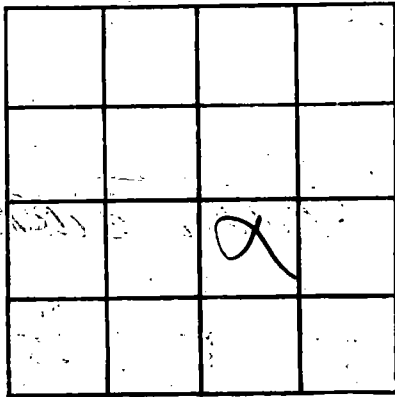

SECTION _____

Please indicate well location X.

ADDITIONAL INFORMATION

If more than one screen, show locations of each on sketch.