

Harrison  
H 90  
9-6-68

MISSISSIPPI  
 BOARD OF WATER COMMISSIONERS  
 416 North State Street  
 Jackson, Mississippi 39201

WATER WELL DRILLERS LOG

**CODED**

Sept. 6 1968 M&B Drilling Co. Harrison  
 date well completed firm name county well located

LANDOWNER: Paul Wyrosky, Jr.  
R.R. Biloxi, Miss.

(mailing address)

WELL LOCATION:  
 sec. 24 T. 6 S. R. 10 W.  
7 miles N of Biloxi  
 (distance) (direction) (nearest town)

WELL PURPOSE: Home  
 (home, irrigation, municipal, industrial)

WELL COMPLETION DATA:

- (1) diameter (inches) 4 1/2
  - (2) total depth (feet) 167
  - (3) static water level (feet) 73 below  
 top of ground.
  - (4) casing PVC Total  
 (material) (depth)  
4 1/2 if telescope see back.  
 (size)
  - (5) screen PFT 152  
 (length) (depth to top)  
2" PVC Sand Pac.  
 (size) (material)
  - (6) pump 1/2 20  
 (HP) (yield gpm)  
230 V 1Ø Submersible  
 (type power) Burks
  - (7) electric log No  
 (yes or no)
- (organization running log)
- (8) how well bottom plugged 2" PVC Cap

description of formations encountered	from	to
Surface Clay	0	14
Sand & Small Gravel	14	40
Clay & " Gravel	40	50
White Clay	50	80
Sand & Clay Breaks	80	85
White Clay	85	95
Blue Clay	95	102
Sand	102	105
Clay	105	115
Coarse Sand	115	160

**CODED**



DEC 10 1968

DRILLERS REMARKS:

MISS. BD. OF  
 WATER COMM.

If well telescopes please sketch and show depths.

GROUND LEVEL

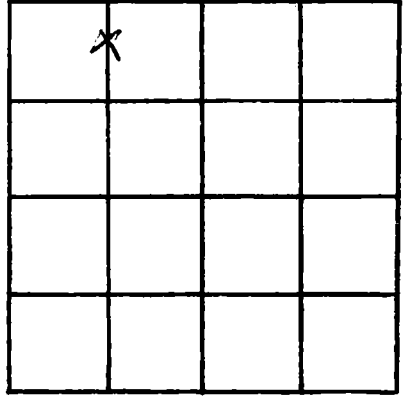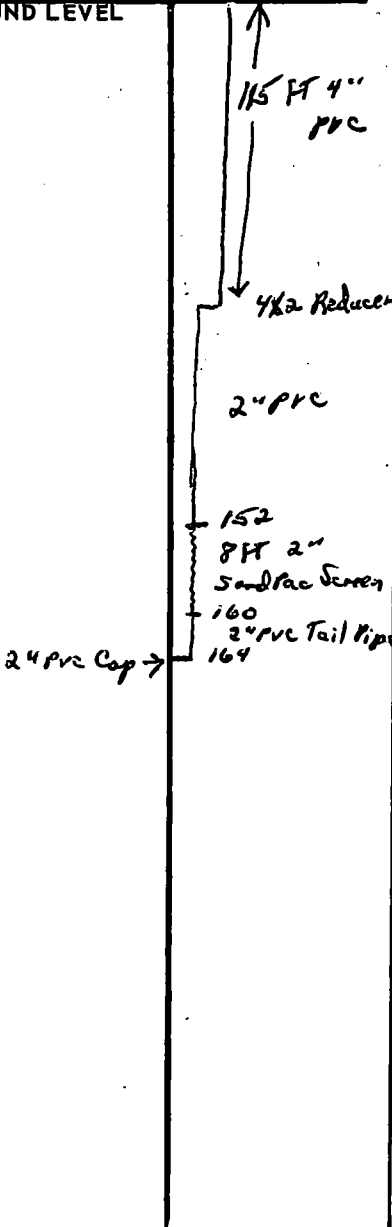

SECTION 24

Please indicate well location X.

ADDITIONAL INFORMATION

If more than one screen, show locations of each on sketch.