

HARRISON
H 91
11-28-68

MISSISSIPPI
BOARD OF WATER COMMISSIONERS
416 North State Street
Jackson, Mississippi 39201

WATER WELL DRILLERS LOG

CODED

Nov. 28 1968 M & B Drilling Co. Harrison
date well completed firm name county well located

LANDOWNER: Bowell
Biloxi River Estates + John Rd.
R.R. Gulfport, Miss.
(mailing address)

WELL LOCATION:
sec. 36.6 T. 6 S. R. 10 W.
3 1/2 miles E of Nugent
(distance) (direction) (nearest town)

WELL PURPOSE: Home
(home, irrigation, municipal, industrial)

WELL COMPLETION DATA:

- (1) diameter (inches) 2
- (2) total depth (feet) 260 FT
- (3) static water level (feet) 31 below
top of ground.
- (4) casing PVC, 247,
(material) (depth)
2"
(size) if telescope see back.
- (5) screen 9 FT, 247
(length) (depth to top)
2", PVC Sand Pac
(size) (material)
- (6) pump 1/2 HP, 8
(HP) (yield gpm)
220V 1P Sears Roebuck
(type power)
- (7) electric log No
(yes or no)
- (organization running log)
- (8) how well bottom plugged
2" PVC Cap

description of formations encountered	from	to
Surface	0	8
Red Clay	8	20
Red Clay Sand Breaks	20	48
Sand	48	60
White Clay	60	78
Blue Clay	78	88
Brown Sand	88	104
Blue Clay	104	235
Sand	235	255
Blue Clay	255	260

Circulation logs 210 235

CODED


DEC 10 1968

MISS. BD. OF
WATER COMM.

DRILLERS REMARKS:

If well telescopes please sketch and show depths.

GROUND LEVEL

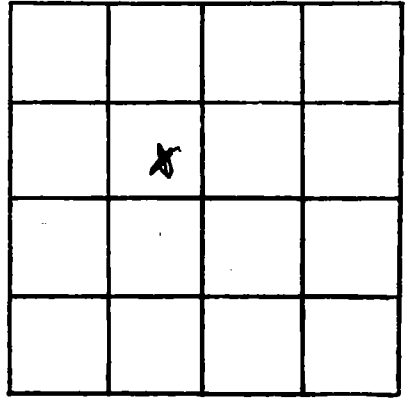

SECTION 36

Please indicate well location X.

ADDITIONAL INFORMATION

Horizontal lines for recording additional information.

If more than one screen, show locations of each on sketch.