

CODED

MISSISSIPPI
BOARD OF WATER COMMISSIONERS
416 North State Street
Jackson, Mississippi 39201

WATER WELL DRILLERS LOG

HARRISON
H 95
6-19-69

June 18 1969 L.L. Garland water wells Jackson Harrison
date well completed firm name county well located

LANDOWNER: Davis Gayard
145 Saucier St
Belopi, Miss
(mailing address)

description of formations encountered from to

WELL LOCATION:

sec. 33 T. 6 N. R. 9 E
4 miles west of Belopi, Miss
(distance) (direction) (nearest town)

WELL PURPOSE: home
(home, irrigation, municipal, industrial)

WELL COMPLETION DATA:

- (1) diameter (inches) 2"
- (2) total depth (feet) 311
- (3) static water level (feet) 20 below above top of ground.
- (4) casing steel, 301,
(material) (depth)
2 if telescope see back.
(size)
- (5) screen 10ft, 301ft
(length) (depth to top)
8 gauge, stainless steel
(size) (material)
- (6) pump none (yield gpm)
(type of pump)
customer own
- (7) electric log (yes or no)

(organization running log)

(8) how well bottom plugged metal valve

JUN 23 1969


MISS. BD. OF WATER COMMISSIONERS

DRILLERS REMARKS:

38 ft. of water bearing sand

If well telescopes please sketch and show depths.

GROUND LEVEL

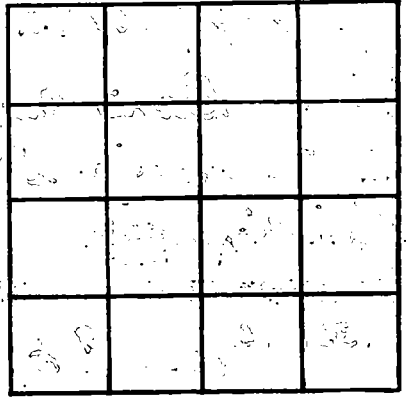

SECTION _____

Please indicate well location X.

ADDITIONAL INFORMATION

Lined area for additional information, consisting of approximately 20 horizontal lines.

If more than one screen, show locations of each on sketch.