

Harrison
H 96
5-23-69

MISSISSIPPI
BOARD OF WATER COMMISSIONERS
416 North State Street
Jackson, Mississippi 39201

CODED

WATER WELL DRILLERS LOG

May 23 1969 M+B Drilling Co. Harrison
date well completed firm name county well located

LANDOWNER: H.C. Payne
943 Van Eaton Circle
Biloxi, Miss.
(mailing address)

WELL LOCATION:
sec. 29 T. 6 S. R. 9 E
5 miles N of Biloxi
(distance) (direction) (nearest town)

WELL PURPOSE:
(home, irrigation, municipal, industrial)

WELL COMPLETION DATA:
(1) diameter (inches) 2"
(2) total depth (feet) 407
(3) static water level (feet) 10 below top of ground.
(4) casing PRC Total (material) (depth)
2" if telescope see back.
(5) screen 2 FT 407 (length) (depth to top)
2" PRC Sand Pac (size) (material)
(6) pump 1/5 (HP) (yield gpm)
220V 1P (type power)
(7) electric log No (yes or no)
(organization running log)
(8) how well bottom plugged 2" PRC Cap

description of formations encountered	from	to
Surface	0	4
Brown Clay	4	12
Black Muck	12	16
Light Grey Clay	16	24
Dark Grey Clay	24	33
Black Muck	33	38
White Sand Gravel	38	46
Blue Clay	46	72
Fine Sand & Clay	72	76
Soft Blue-Gray Clay	76	140
Hard Blue Clay	140	150
Soft light blue clay	150	179
Sand	179	184
Hard Blue Clay	184	214
Fine Sand	214	219
Blue Clay	219	370
Fine Sand	370	390
Medium Sand	390	417
Blue Clay	417	432+


JUN 2 - 1969

MISS. BD. OF
WATER COMM.

DRILLERS REMARKS:

If well telescopes please sketch and show depths.

GROUND LEVEL

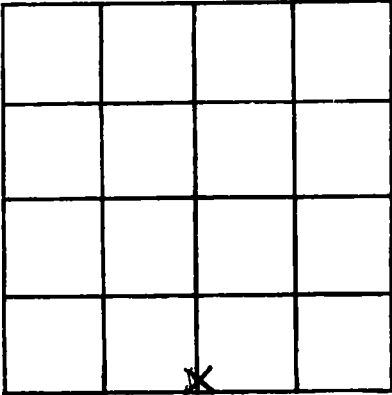

SECTION 29

Please indicate well location X.

ADDITIONAL INFORMATION

A series of horizontal lines for entering additional information.

If more than one screen, show locations of each on sketch.