

CODED

MISSISSIPPI
BOARD OF WATER COMMISSIONERS
416 North State Street
Jackson, Mississippi 39201

WATER WELL DRILLERS LOG

Harrison
H 98.
7-29-69

7/29 1969 Coastal Drilling Service Herin
date well completed firm name county well located

LANDOWNER: Mum
Moate Rt 1 of 372
Ocean Springs Min.
(mailing address)

description of formations encountered	from	to
top soil	1	10
white sand	10	20
glau.	20	35
blue clay	35	220
fine blue sand	220	230
pebbles sand	230	240
very coarse sand	240	256

WELL LOCATION:
sec. 38 T 6 N R 9 E
3 miles NE of O.S.
(distance) (direction) (nearest town)

WELL PURPOSE: home
(home, irrigation, municipal, industrial)

- WELL COMPLETION DATA:
- (1) diameter (inches) 2"
 - (2) total depth (feet) 256'
 - (3) static water level (feet) _____ below above top of ground.
 - (4) casing glau. 256' (material) (depth)
(size) If telescope see back.
 - (5) screen 10' (length) (depth to top)
2" (size) SS (material)
 - (6) pump 1 HP (HP) 19 (yield gpm)
Etc (type power)
 - (7) electric log _____ (yes or no)
(organization running log)
 - (8) how well bottom plugged good


DRILLERS REMARKS:
None

OCT 31 1969

MISS. BD. OF
WATER COMM.

If well telescopes please sketch and show depths.

GROUND LEVEL

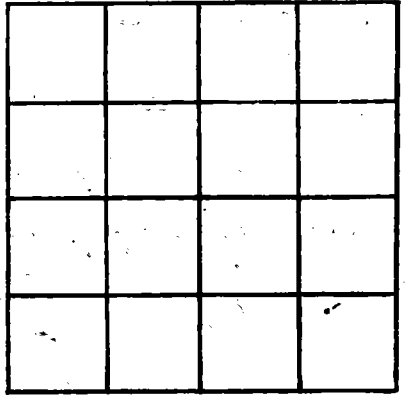

SECTION 28

Please indicate well location X.

ADDITIONAL INFORMATION

Lined area for providing additional information, consisting of approximately 20 horizontal lines.

If more than one screen, show locations of each on sketch.