

CODED

MISSISSIPPI
BOARD OF WATER COMMISSIONERS
416 North State Street
Jackson, Mississippi 39201

Harrison
H 99
9-4-69

WATER WELL DRILLERS LOG

9/4 1969 (Coastal Drilling) Harrison
date well completed firm name county well located

LANDOWNER: Dr. Harrison
Rt 1 Box 145 B
East, Miss
(mailing address)

description of formations encountered	from to	
	feet	feet
Top Soil	1	5
Red Clay	5	15
Sand	15	20
Blue Clay	20	160
fine sand	160	180
very hard clay	180	280
Coastal water Sand	280	308

WELL LOCATION:
sec 36 T 6 R 10 E
3 miles NW Woodstock
(distance) (direction) (nearest town)

WELL PURPOSE: home
(home, irrigation, municipal, industrial)

WELL COMPLETION DATA:

- (1) diameter (inches) 2"
- (2) total depth (feet) 308'
- (3) static water level (feet) _____ below above top of ground.
- (4) casing Galv 308'
(material) (depth)
(size) If telescope see back.
- (5) screen 10' _____
(length) (depth to top)
24 _____
(size) (material)
- (6) pump 1/2 HP 15
(HP) (yield gpm)
Electric
(type power)
- (7) electric log _____
(yes or no)
(organization running log)
- (8) how well bottom plugged Sand


DRILLERS REMARKS:
None

OCT 31 1969

MISS. BD. OF
WATER COMM.

If well telescopes please sketch and show depths.

GROUND LEVEL

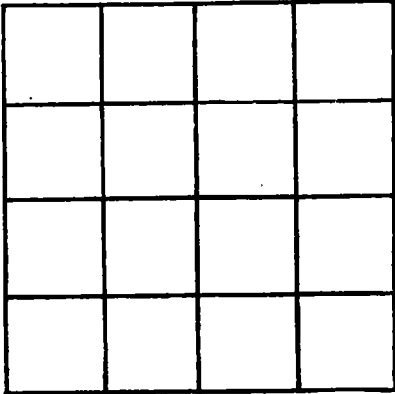

SECTION 36

Please indicate well location X.

ADDITIONAL INFORMATION

Lined area for additional information.

If more than one screen, show locations of each on sketch.