

HARRISON
 H105
 11-8-69

MISSISSIPPI
 BOARD OF WATER COMMISSIONERS
 416 North State Street
 Jackson, Mississippi 39201

CODED

WATER WELL DRILLERS LOG

11-8-69 19 R. J. MOORE HARRISON
 date well completed firm name county well located

LANDOWNER: Pete BRALAND
RT 3 JOHN ROSS RD
GULFPORT, MISS
 (mailing address)

description of formations encountered	from	to
TOP SOIL	0	20
RED SAND & clay	20	42
white clay	42	94
FINE SAND	94	114
Blue clay	114	184
Blue SAND	184	204

WELL LOCATION:
 sec. 31 T. 6 N R. 10 E
2 1/2 miles WEST of WALNUT
 (distance) (direction) (nearest town)

WELL PURPOSE: TRAILOR
 (home, irrigation, municipal, industrial)

- WELL COMPLETION DATA:
- diameter (inches) 2"
 - total depth (feet) 204'
 - static water level (feet) 42 below above top of ground.
 - casing 9ALV 188'
 (material) (depth)
 if telescope see back.
 (size)
 - screen 2x10 188'
 (length) (depth to top)
2" SS
 (size) (material)
 - pump
 (HP) (yield gpm)

 (type power)
 - electric log
 (yes or no)


 (organization running log)
 - how well bottom plugged BC

DRILLERS REMARKS:

NOV 12 1969
 MISS. BD. OF
 WATER COM.

If well telescopes please sketch and show depths.

GROUND LEVEL

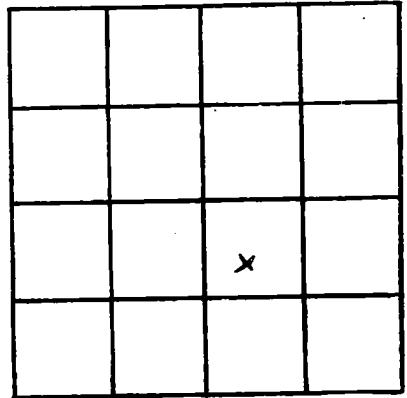

SECTION _____

Please indicate well location X.

ADDITIONAL INFORMATION

If more than one screen, show locations of each on sketch.