

CODED
CODED

Harrison
#106
10-25-69

MISSISSIPPI
BOARD OF WATER COMMISSIONERS
416 North State Street
Jackson, Mississippi 39201

WATER WELL DRILLERS LOG

10/25 date well completed 169 Coastal Drilling firm name Harrison county well located

LANDOWNER: John Wolfe
Rt 1 Box 787
Brook Miss
(mailing address)

WELL LOCATION:
sec. 19 T 6N S R. 10 E W
2 miles NW Brookmiss
(distance) (direction) (nearest town)

WELL PURPOSE: home
(home, irrigation, municipal, industrial)

WELL COMPLETION DATA:

- (1) diameter (inches) 2"
- (2) total depth (feet) 423
- (3) static water level (feet) 16 below above top of ground.
- (4) casing galv, 423,
(material) (depth)
(size) if telescope see back.
- (5) screen 10', 413
(length) (depth to top)
2", SS
(size) (material)
- (6) pump 1HP, 21
(HP) (yield gpm)
Ele
(type power)
- (7) electric log NO
(yes or no)

(organization running log)
(8) how well bottom plugged BW goal


DRILLERS REMARKS:
none

description of formations encountered	from	to
Red Clay	1	12
Coarse white sand	12	47
White Clay	47	100
Blue Clay	100	325
Heavy hard Blue Clay	325	350
Rock	350	352
fine water sand	352	375
Coarse water sand	375	423

JAN 18 1970
MISS. BO. OF
WATER COM.

If well telescopes please sketch and show depths.

GROUND LEVEL

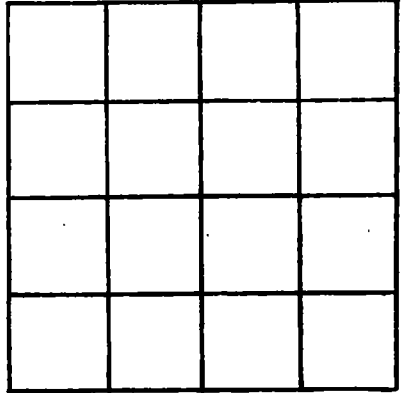

SECTION _____

Please indicate well location X.

ADDITIONAL INFORMATION

If more than one screen, show locations of each on sketch.