

Narrison  
H 107  
10-26-69

MISSISSIPPI  
 BOARD OF WATER COMMISSIONERS  
 416 North State Street  
 Jackson, Mississippi 39201

CODED.  
 CODED.

WATER WELL DRILLERS LOG

10/26 1969 Coastal Drilling NARRISON  
 date well completed firm name county well located

LANDOWNER: L. E. Roberts  
Rt 1 Box 765  
Biloxi, Miss  
 (mailing address)

WELL LOCATION:  
 sec 28 T 6 N R 10 E  
           S                    W  
3 miles NW Woodmohr  
 (distance) (direction) (nearest town)

WELL PURPOSE: home  
 (home, irrigation, municipal, industrial)

WELL COMPLETION DATA:

- (1) diameter (inches) 2
- (2) total depth (feet) 465
- (3) static water level (feet) 34 below  
 top of ground.
- (4) casing galv 465  
 (material) (depth)  
 (size) If telescope see back.
- (5) screen 10' 455  
 (length) (depth to top)  
2" S.S.  
 (size) (material)
- (6) pump 1 HP 21  
 (HP) (yield gpm)  
Ele  
 (type power)
- (7) electric log NO  
 (yes or no)

(organization running log)  
 (8) how well bottom plugged BW  
good

DRILLERS REMARKS:  
none


description of formations encountered	from	to
<u>Red Clay</u>	<u>1</u>	<u>12</u>
<u>Coarse White Sand</u>	<u>12</u>	<u>45</u>
<u>White Clay</u>	<u>45</u>	<u>60</u>
<u>White Sand</u>	<u>60</u>	<u>75</u>
<u>Sugar Sand</u>	<u>75</u>	<u>125</u>
<u>Blue Clay</u>	<u>125</u>	<u>240</u>
<u>fine water sand</u>	<u>240</u>	<u>260</u>
<u>light Blue Clay</u>	<u>260</u>	<u>380</u>
<u>fine water sand</u>	<u>380</u>	<u>400</u>
<u>Coarse Water Sand</u>	<u>400</u>	<u>465</u>

JAN 12 1970

MISS. Bd. of  
 WATER COMMISSIONERS

If well telescopes please sketch and show depths.

GROUND LEVEL

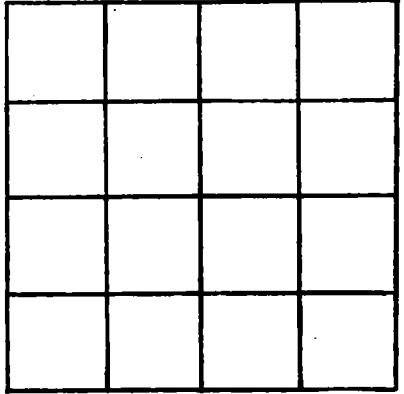

SECTION \_\_\_\_\_

Please indicate well location X.

ADDITIONAL INFORMATION

If more than one screen, show locations of each on sketch.