

MISSISSIPPI
 BOARD OF WATER COMMISSIONERS
 416 North State Street
 Jackson, Mississippi 39201

CODED.
 CODED

WATER WELL DRILLERS LOG

Harrison
H 10B
10-27-69

10/27 1969 LA Coastal Drilling Harrison
 date well completed firm name county well located

LANDOWNER: Bob
WILLIAMS Rt 1 Bx 704
Biloxi, MISS
 (mailing address)

| description of formations encountered | depth | |
|---------------------------------------|------------|------------|
| | from | to |
| <u>Red Clay</u> | <u>1</u> | <u>15</u> |
| <u>White Sand</u> | <u>15</u> | <u>36</u> |
| <u>Galena</u> | <u>36</u> | <u>50</u> |
| <u>light blue clay</u> | <u>50</u> | <u>230</u> |
| <u>fine water sand</u> | <u>230</u> | <u>240</u> |
| <u>Coarse water sand</u> | <u>240</u> | <u>275</u> |

WELL LOCATION:
 sec. 32 T. 6 S. R. 10 W.
Woodward
 (distance) (direction) of (nearest town)

WELL PURPOSE: home
 (home, irrigation, municipal, industrial)

- WELL COMPLETION DATA:
- (1) diameter (inches) 2"
 - (2) total depth (feet) 275
 - (3) static water level (feet) 18 below above top of ground.
 - (4) casing Galv 275
 (material) (depth)
 - (size) if telescope see back.
 - (5) screen 10' 265
 (length) (depth to top)
 - 2" SS
 (size) (material)
 - (6) pump 1/2 12
 (HP) (yield gpm)
 - ELC
 (type power)
 - (7) electric log NO
 (yes or no)

(organization running log)
 (8) how well bottom plugged BW
good


DRILLERS REMARKS:
none

JAN 12 1970

MISS. BD. OF
 WATER COM. S.

If well telescopes please sketch and show depths.

GROUND LEVEL

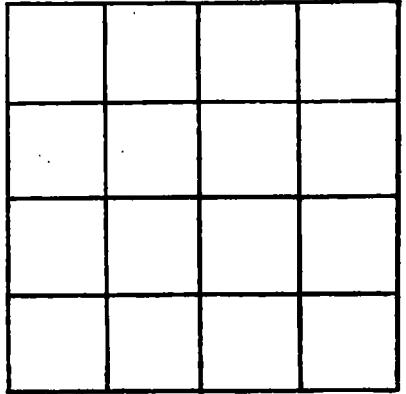

SECTION _____

Please indicate well location X.

ADDITIONAL INFORMATION

If more than one screen, show locations of each on sketch.