

CODED

MISSISSIPPI
BOARD OF WATER COMMISSIONERS
416 North State Street
Jackson, Mississippi 39201

WATER WELL DRILLERS LOG

HARRISON
H 109
1-14-70

1/14/70 19 Coastal Drilling Harrison
date well completed firm name county well located


LANDOWNER	description of formations encountered	from	to
J.M. Stockstill	fill clay	1	10
RT 1 Box 130A	Red clay	10	15
Biloxi, Miss	Sand	15	27
(mailing address)	Red clay	27	50
WELL LOCATION:	clay	50	55
sec. 19 T 6 N R 9 E	Blue clay	55	265
4 miles N of Biloxi	freshwater sand	265	275
(distance) (direction) (nearest town)	coarse water sand	275	300
WELL PURPOSE: <u>home</u>			
(home, irrigation, municipal, industrial)			
WELL COMPLETION DATA:			
(1) diameter (inches) <u>2"</u>			
(2) total depth (feet) <u>300</u>			
(3) static water level (feet) <u>25</u> below above top of ground.			
(4) casing <u>galv</u> , <u>290</u>			
(material) (depth)			
(size) if telescope see back.			
(5) screen <u>10'</u> , <u>290</u>			
(length) (depth to top)			
<u>2"</u> , <u>55</u>			
(size) (material)			
(6) pump <u>1 HP</u> , <u>20</u>			
(HP) (yield gpm)			
<u>Ele</u>			
(type power)			
(7) electric log <u>no</u>			
(yes or no)			
(organization running log)			
(8) how well bottom plugged <u>2 foot water valve</u>			
DRILLERS REMARKS:			
<u>None</u>			

FEB 5 - 1970

MISS. BD. OF
WATER COM.

If well telescopes please sketch and show depths.

GROUND LEVEL

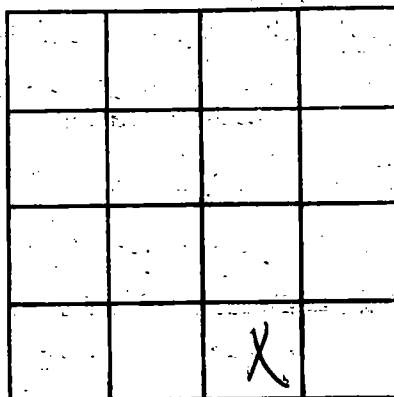

SECTION _____

Please indicate well location X.

ADDITIONAL INFORMATION

If more than one screen, show locations of each on sketch.