

Harrison
H 111
3-27-69

MISSISSIPPI
BOARD OF WATER COMMISSIONERS
416 North State Street
Jackson, Mississippi 39201

WATER WELL DRILLERS LOG

3/27/69 date well completed Coastal Drilling Co. firm name Harrison county well located

LANDOWNER: Effect Raymond
RT 1
Biloff, Miss
(mailing address)

WELL LOCATION:
sec. 26 T. 6 S. R. 10 W.
(2) 1/2 miles NE of Redwater
(distance) (direction) (nearest town)

WELL PURPOSE: home
(home, irrigation, municipal, industrial)

WELL COMPLETION DATA:
(1) diameter (inches) 2"
(2) total depth (feet) 695
(3) static water level (feet) 11 below above top of ground.
(4) casing Galv. 685
(material) (depth)
(size) If telescope see back.
(5) screen 10' 685
(length) (depth to top)
2" 25
(size) (material)
(6) pump 1 HP 15
(HP) (yield gpm)
Elc
(type power)
(7) electric log no
(yes or no)
no
(organization running log)

| description of formations encountered | from | to |
|---------------------------------------|------|-----|
| top soil | 1 | 5 |
| Red Clay | 5 | 23 |
| clay | 23 | 47 |
| white sand | 47 | 64 |
| Blue Clay | 64 | 120 |
| white sand | 120 | 141 |
| Blue Clay | 141 | 188 |
| hard Blue Clay | 188 | 324 |
| fine water sand | 324 | 348 |
| soft Blue Clay | 348 | 450 |
| hard Blue Clay | 450 | 605 |
| Rock | 605 | 606 |
| Shell | 606 | 610 |
| fine water sand | 610 | 635 |
| coarse water sand | 635 | 695 |

CODED

CODED

(8) how well bottom plugged
2" back wash valve


DRILLERS REMARKS:
none

APR - 1 1970

MISS. BD. OF
WATER COMM.

If well telescopes please sketch and show depths.

GROUND LEVEL

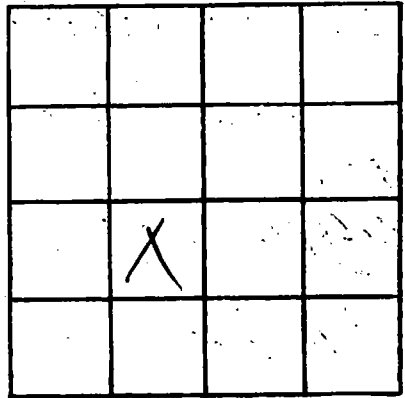

SECTION 26

Please indicate well location X.

ADDITIONAL INFORMATION

If more than one screen, show locations of each on sketch.