

Harrison
H 116
4-20-70

MISSISSIPPI
BOARD OF WATER COMMISSIONERS
416 North State Street
Jackson, Mississippi 39201

CODED

WATER WELL DRILLERS LOG

4/20/70 date well completed
Central Drilling Co. firm name
Harrison county well located

LANDOWNER: L.R. Read
RT 1 Box 711
Biloxi, Miss
(mailing address)

WELL LOCATION:
sec. 33 T 4 R 10 S 20 W
Woolmarket
(distance) miles (direction) (nearest town)

WELL PURPOSE: Home
(home, irrigation, municipal, industrial)

WELL COMPLETION DATA:
(1) diameter (inches) 2"
(2) total depth (feet) 298
(3) static water level (feet) 22 below above top of ground.
(4) casing glaw 288
(material) (depth)
(size) if telescope see back.
(5) screen 16' 288
(length) (depth to top)
2" 55
(size) (material)
(6) pump 1/2 10
(HP) (yield gpm)
Ell
(type power)
(7) electric log no
(yes or no)
(organization running log)

description of formations encountered	from	to
Red Clay	1	7
White Sand	7	14
Red Clay	14	29
White Sand	29	35
Blue Clay	35	205
fine water sand	205	217
Coarse water sand	217	220
Blue Clay	220	263
fine water sand	263	277
Coarse water sand	277	298


(8) ~~has~~ well bottom plugged
2 back wash valves
DRILLERS REMARKS:
None

MAY 7 1970

MISS. BD. OF
WATER COMM.

If well telescopes please sketch and show depths.

GROUND LEVEL

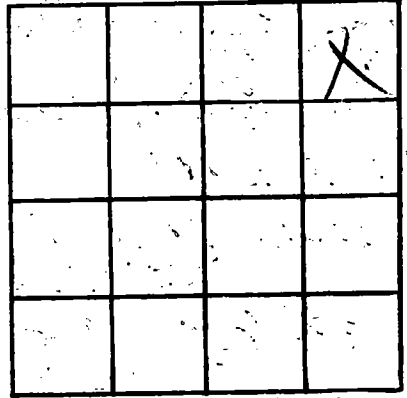

SECTION _____

Please indicate well location X.

ADDITIONAL INFORMATION

If more than one screen, show locations of each on sketch.