

Harrison  
 H 117  
 4-24-70

MISSISSIPPI  
 BOARD OF WATER COMMISSIONERS  
 416 North State Street  
 Jackson, Mississippi 39201

CODED

WATER WELL DRILLERS LOG

4/24/70 19 Coastal Drilling Co. Harrison  
 date well completed firm name county well located

LANDOWNER: Clark Johnson  
 Rt 1 257B  
 Biloxi Marsh  
 (mailing address)

description of formations encountered	from	to
Red Clay	1	5
Blue Clay	5	25
white sand	25	37
Silt Sand	37	60
Blue Clay	60	200
hard Blue Clay	200	301
Coarse white sand	301	318

WELL LOCATION:  
 sec 21 T 6 S R 10 E 209  
 2 miles N of Coahulla  
 (distance) (direction) (nearest town)

WELL PURPOSE: Home  
 (home, irrigation, municipal, industrial)

WELL COMPLETION DATA:  
 (1) diameter (inches) 2"  
 (2) total depth (feet) 318  
 (3) static water level (feet) 24 below top of ground  
 (4) casing glass 308  
 (material) (depth)  
 (size) If telescope see back.  
 (5) screen 10' 308  
 (length) (depth to top)  
 2" 28  
 (size) (material)  
 (6) pump 1 HP 18  
 (type power) (yield gpm)  
 Ede  
 (7) electric log No  
 (yes or no)  
 (organization running log)

(8) how well bottom plugged  
 2" back wash valve


DRILLERS REMARKS:  
 None

MAY 7 1970

MISS. BD. OF  
 WATER COMM.

If well telescopes please sketch and show depths.

GROUND LEVEL

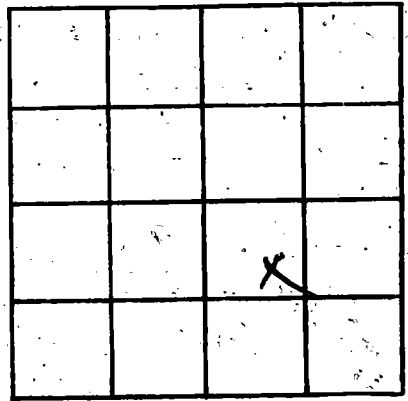

SECTION \_\_\_\_\_

Please indicate well location X.

ADDITIONAL INFORMATION

If more than one screen, show locations of each on sketch.