

HARRISON
H 121
9-1-70

MISSISSIPPI
BOARD OF WATER COMMISSIONERS
416 North State Street
Jackson, Mississippi 39201

CODED

WATER WELL DRILLERS LOG

9-1-1970 R. J. Moore HARRISON
date well completed firm name county well located

LANDOWNER: WALTER BURN
Bolivi River Estate
RT 3 Guesport, Miss
(mailing address)

description of formations encountered	from	to
TOP SOIL	0	10
Red Sand	10	19
White Clay	19	80
White Sand	80	85
Blue Clay	85	220
Blue Sand	220	240

WELL LOCATION:
sec 31 T 6 N R 10 E
2 1/2 miles WEST of Waltham
(distance) (direction) (nearest town)

WELL PURPOSE:
(home, irrigation, municipal, industrial)

WELL COMPLETION DATA:

(1) diameter (inches) 2"

(2) total depth (feet) 240'

(3) static water level (feet) 65' ^{below} above top of ground.

(4) casing galv 230'
(material) (depth)
(size) If telescope see back.

(5) screen 2x10 230'
(length) (depth to top)
2" SS
(size) (material)

(6) pump _____
(HP) (yield gpm)
(type power)

(7) electric log _____
(yes or no)
(organization running log)

(8) how well bottom plugged BW
with

CODED


DRILLERS REMARKS: _____

SEP 14 1970

MISS. Bd. of WATER COMM.

If well telescopes please sketch and show depths.

GROUND LEVEL

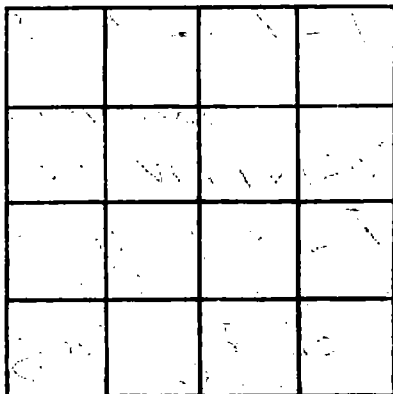

SECTION _____

Please indicate well location X.

ADDITIONAL INFORMATION

If more than one screen, show locations of each on sketch.