

Harrison
H124
4-24-70

MISSISSIPPI
 BOARD OF WATER COMMISSIONERS
 416 North State Street
 Jackson, Mississippi 39201

CODED

WATER WELL DRILLERS LOG

4-24 1970 Switzer Well Co. Harrison
 date well completed firm name county well located

LANDOWNER: C. L. Toume

RE. 1 Box 600A

Biloxi, Miss.
 (mailing address)

WELL LOCATION:

sec. 33 T. 6 R. 10
6 miles NW of BILOXI
 (distance) (direction) (nearest town)

WELL PURPOSE:
 (home, irrigation, municipal, industrial)

WELL COMPLETION DATA:

- (1) diameter (inches) 2"
- (2) total depth (feet) 458'
- (3) static water level (feet) 40 ^{below} _{above} top of ground.
- (4) casing galv., 458'
 (material) (depth)
 (size) if telescope see back.
- (5) screen 10', 448'
 (length) (depth to top)
008, stainless steel
 (size) (material)
- (6) pump 1/2, 15
 (HP) (yield gpm)
ell.
 (type power)
- (7) electric log No
 (yes or no)

(organization running log)

(8) how well bottom plugged back
pressure valve

DRILLERS REMARKS:

description of formations encountered

from to

clay	1	16
gravel	16	27
shale & gravel	27	42
clay	42	130
sand	130	140
clay	140	142
sand fine	142	167
clay	167	202
sand	202	217
clay	217	234
sand	234	247
clay	247	262
sand fine	262	290
clay	290	382
sand	382	458

CODED

JUN 16 1970


MISS. BD. OF
 WATER COM.

If well telescopes please sketch and show depths.

GROUND LEVEL

1. 10' 2. 10' 3. 10' 4. 10' 5. 10' 6. 10' 7. 10' 8. 10' 9. 10' 10. 10' 11. 10' 12. 10' 13. 10' 14. 10' 15. 10' 16. 10' 17. 10' 18. 10' 19. 10' 20. 10'

1. 10' 2. 10' 3. 10' 4. 10' 5. 10' 6. 10' 7. 10' 8. 10' 9. 10' 10. 10' 11. 10' 12. 10' 13. 10' 14. 10' 15. 10' 16. 10' 17. 10' 18. 10' 19. 10' 20. 10'

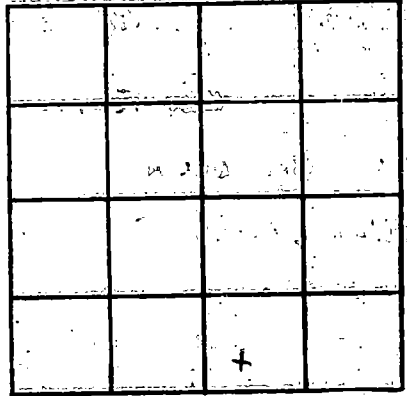

SECTION 33

Please indicate well location X.

ADDITIONAL INFORMATION

If more than one screen, show locations of each on sketch.