

Harrison
H128
7-1-70

MISSISSIPPI
 BOARD OF WATER COMMISSIONERS
 416 North State Street
 Jackson, Mississippi 39201

WATER WELL DRILLERS LOG

7/1/70 19 Coastal Drilling Co. Harrison
 date well completed firm name county well located

LANDOWNER E.M. Roberts
Rt 2 Box 306 L15
Biloxi, Miss
 (mailing address)

description of formations encountered	from	to
Top Soil	1	4
White Sand	4	22
Sugar Sand	22	39
fine water sand	39	47
hard Blue Clay	47	205
fine water sand	205	237
hard Blue Clay	237	260
fine water sand	260	275
Coarse water sand	275	292

WELL LOCATION:
 sec. 29 T. 6 N. R. 9 W.
(5) 1/2 miles N of Biloxi
 (distance) (direction) (nearest town)

WELL PURPOSE: home
 (home, irrigation, municipal, industrial)


WELL COMPLETION DATA:
 (1) diameter (inches) 2"
 (2) total depth (feet) 292'
 (3) static water level (feet) 22' below above top of ground.
 (4) casing galv. 292'
 (material) (depth)
 (size) If telescope see back.
 (5) screen 10' 292'
 (length) (depth to top)
2" S.S.
 (size) (material)
 (6) pump 1 1/2 17
 (HP) (yield gpm)
alk
 (type power)
 (7) electric log no
 (yes or no)
 (organization running log)

(8) how well bottom plugged 2' sand which valve
 DRILLERS REMARKS: None

JUL 14 1970
 MISS. Bd. OF
 WATER COMMISSIONERS

If well telescopes please sketch and show depths.

GROUND LEVEL

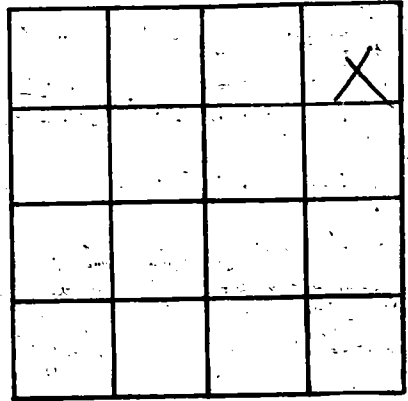

SECTION _____

Please indicate well location X.

ADDITIONAL INFORMATION

If more than one screen, show locations of each on sketch.