

HARRISON  
H130  
9-23-70

MISSISSIPPI  
BOARD OF WATER COMMISSIONERS  
416 North State Street  
Jackson, Mississippi 39201

**CODED**

WATER WELL DRILLERS LOG

9/23 1970 Central Drilling Harrison  
date well completed firm name county well located

LANDOWNER: W.C. Jantzen

description of formations encountered

from to

RT 2 Box 262A  
Biola, Miss  
(mailing address)

Top Soil	1	5
Red Clay	5	40
White Sandstone	40	215
Hard Blue Clay	215	329
fine water sand	289	325
Coarse water sand	325	357

WELL LOCATION:

sec. 23 T. 6 S. R. 10 E.  
2 1/2 miles SE of Biola  
(distance) (direction) (nearest town)

WELL PURPOSE: Home  
(home, irrigation, municipal, industrial)

WELL COMPLETION DATA:

- (1) diameter (inches) 2"
  - (2) total depth (feet) 357
  - (3) static water level (feet) 25 below top of ground.
  - (4) casing galv. 347  
(material) (depth)  
(size) If telescope see back.
  - (5) screen 10' 347  
(length) (depth to top)  
2" SS  
(size) (material)
  - (6) pump 1 HP 15  
(HP) (yield gpm)  
Self  
(type power)
  - (7) electric log no  
(yes or no)
- (organization running log)

**CODED**

(8) how well bottom plugged  
2 Barbara Hales


SEP 30 1970

DRILLERS REMARKS:

None

If well telescopes please sketch and show depths.

GROUND LEVEL

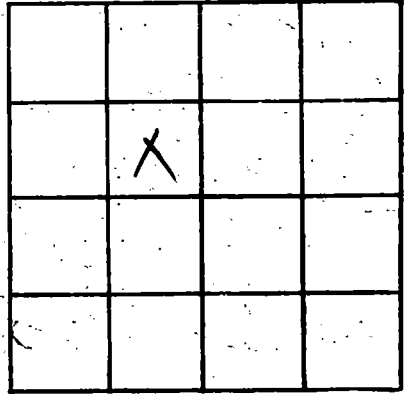

SECTION \_\_\_\_\_

Please indicate well location X.

ADDITIONAL INFORMATION

If more than one screen, show locations of each on sketch.