

HARRISON
 H 131
 7-8-70

MISSISSIPPI
 BOARD OF WATER COMMISSIONERS
 416 North State Street
 Jackson, Mississippi 39201

CODED

WATER WELL DRILLERS LOG

7/8/70 date well completed
 Coastal Drilling Co. firm name
 Jawn county well located

LANDOWNER: John M. Shivers
 Jim Beckett I
 Bilopi, Miss (mailing address)

description of formations encountered	from	to
Topsoil	1	3
Red clay	3	11
Sand gravel	11	12
Blue clay	12	20
hard blue clay	20	24
Blue clay	24	28
hard blue sand	30	32
Concrete sand	32	35

WELL LOCATION:
 sec. 34 T. 6 N. R. 10 E
 S W
 3 miles E Walnut (distance) (direction) (nearest town)

WELL PURPOSE: home
 (home, irrigation, municipal, industrial)

WELL COMPLETION DATA:
 (1) diameter (inches) 2"
 (2) total depth (feet) 335
 (3) static water level (feet) 28 below top of ground.
 (4) casing 325 (material) (depth)
 (size) if telescope see back.
 (5) screen 10' 325 (length) (depth to top)
 10' 55 (size) (material)
 (6) pump 1/2 HP 16 (type power) (yield gpm)
 (7) electric log yes (yes or no)
 (organization running log)

CODED

(8) how well bottom plugged
 2" fresh water
 DRILLERS REMARKS:


AUG 4 1970

None

MISS. B.D. OF

If well telescopes please sketch and show depths.

GROUND LEVEL

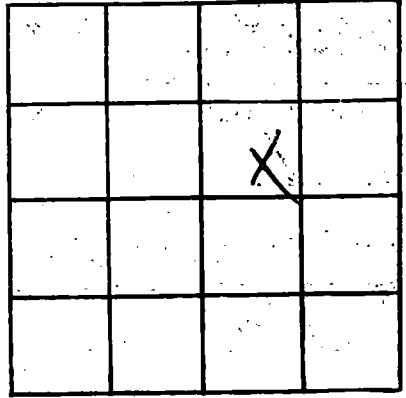

SECTION _____

Please indicate well location X.

ADDITIONAL INFORMATION

If more than one screen, show locations of each on sketch.