

HAR.

MISSISSIPPI BOARD OF WATER COMMISSIONERS

OH 140 A106911 C

7-3-63

WATER WELL DRILLERS LOG

CODED

Date: July 3, 1963, Driller: Hattisburg Butane County Harrison


- (1) Owner of Land: O.G. Foreman (Name)
Hattisburg (Address)
- (2) Location: 1/4, 1/4, Sec. 24 T6 R10
3 miles N of Hwy '67 (distance) (direction) (Nearest Town)
- (3) Topography: (Hilly) (Flat) (Level) X
- (4) Purpose of Well: Domestic (Domestic Irrigation, Municipal, Industrial, Other)

Description & Color of Materials Sand, Clay, Red Clay, Shell, etc.	Thick- ness Feet	Depth Feet
Yellow Clay	0-11	
Blue Clay	11-25	
White Clay	25-52	
Blue Clay	52-150	
Blue Sand	150-155	
Blue Clay	155-190	
Blue Sand	190-220	

Information upon completion of well:

- (1) Diameter 2" inches.
- (2) Total Depth 220 feet.
- (3) Water Level 3 feet below top of ground.
- (4) Cased to _____, Size _____
- (5) Screen: Size 2", Length 16'
- (6) Were any formations sealed against pollution?
_____ yes, X no.

CODED

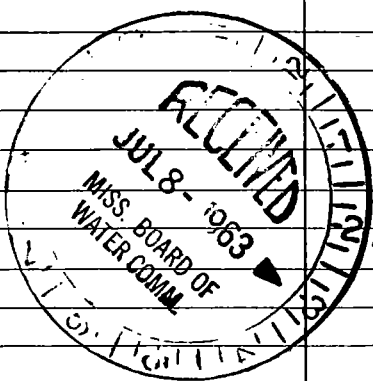

If YES depth of formation _____
 Why _____
 Drillers Remarks: _____

(Use Back Side)

Well No.

1900

1900