

HARRISON
H 145
4-5-71

MISSISSIPPI
BOARD OF WATER COMMISSIONERS
416 North State Street
Jackson, Mississippi 39201

CODED

WATER WELL DRILLERS LOG

4/5/71 *Coastal Drilling Co.* Harrison
date well completed firm name county well located

LANDOWNER: *Marie Styer*
 Rt 2 Box 612
 Bilep Miss
(mailing address)

WELL LOCATION:
sec *25* T *6* S R *10* E
1 1/2 miles *N* *Cedar Lake*
(distance) (direction) (nearest town)

WELL PURPOSE: *home*
(home, irrigation, municipal, industrial)

WELL COMPLETION DATA:
(1) diameter (inches) *2"*
(2) total depth (feet) *710*
(3) static water level (feet) *44* below above top of ground.
(4) casing *glau* *690*
(material) (depth)
(size) if telescope see back.
(5) screen *20'* *690*
(length) (depth to top)
2T *SS.*
(size) (material)
(6) pump *one* *17 1/2*
(HP) (yield gpm)
Ele
(type power)
(7) electric log *no*
(yes or no)
(organization running log)

(8) how well bottom plugged
2 1/2' below valve

DRILLERS REMARKS:
none

description of formations encountered	from	to
<i>top soil</i>	<i>4</i>	<i>4</i>
<i>Red Clay</i>	<i>4</i>	<i>15</i>
<i>glau</i>	<i>15</i>	<i>39</i>
<i>white sand</i>	<i>39</i>	<i>45</i>
<i>blue clay</i>	<i>45</i>	<i>90</i>
<i>hard blue clay</i>	<i>90</i>	<i>200</i>
<i>very hard blue clay</i>	<i>200</i>	<i>420</i>
<i>Rock</i>	<i>420</i>	<i>421</i>
<i>fine water sand</i>	<i>421</i>	<i>490</i>
<i>blue sand clay</i>	<i>490</i>	<i>620</i>
<i>water fine water sand</i>	<i>620</i>	<i>650</i>
<i>water water sand</i>	<i>650</i>	<i>710</i>


CODED

MAY 18 1971

MISS. BD OF WATER COM.

If well telescopes please sketch and show depths.

GROUND LEVEL

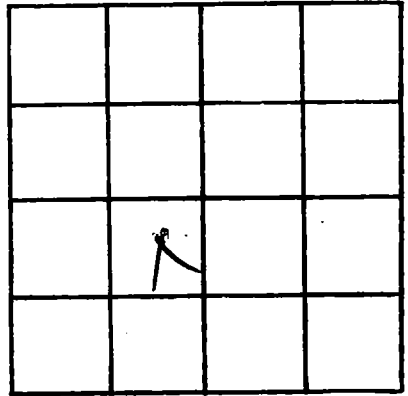

SECTION _____

Please indicate well location X.

ADDITIONAL INFORMATION

If more than one screen, show locations of each on sketch.