

HARRISON
 H ~~151~~
 6-16-71

MISSISSIPPI
 BOARD OF WATER COMMISSIONERS
 416 North State Street
 Jackson, Mississippi 39201
 WATER WELL DRILLERS LOG

CODED

6-16-71 19
 date well completed

R. J. Moore
 firm name

HARRISON
 county well located

LANDOWNER: W. J. SPENDER
Highway 15 + 17
BiLoki, MISS
 (mailing address)
 WELL LOCATION:
 sec 33 T 6 N R 9 E
 CORNER 17 15 + 67
2 miles N of BiLoki
 (distance) (direction) (nearest town)

description of formations encountered	from	to
TOP SOIL	0	10
white sand	10	40
white clay	40	80
blue clay	80	262
gray sand shale	262	293
blue clay	293	534
gray sand med	534	588

WELL PURPOSE:
 (home, irrigation, municipal, industrial)

WELL COMPLETION DATA:

- (1) diameter (inches) 2"
- (2) total depth (feet) 588'
- (3) static water level (feet) 4' ^{below} _{above} top of ground.
- (4) casing 2 1/2" 568'
 (material) (depth)
- _____ If telescope see back.
 (size)
- (5) screen 2x20 568'
 (length) (depth to top)
- 2" SS
 (size) (material)
- (6) pump _____
 (HP) (yield gpm)
- _____ (type power)
- (7) electric log (yes or no) _____
- _____ (organization running log)

CODED

JUL 13 1971


(8) how well bottom plugged BU
2 1/2"

MISS. RD. OR
 WATER COMM.

DRILLERS REMARKS:

If well telescopes please sketch and show depths.

GROUND LEVEL

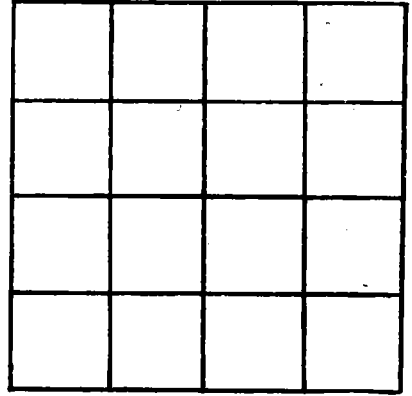

SECTION _____

Please indicate well location X.

ADDITIONAL INFORMATION

If more than one screen,
show locations of each on sketch.