

HARRISON
H-156
6-22-71

MISSISSIPPI
BOARD OF WATER COMMISSIONERS
416 North State Street
Jackson, Mississippi 39201

X

WATER WELL DRILLERS LOG

CODED

6/22/71 date well completed
Coastal Drilling Co. firm name
Harrison county well located

LANDOWNER: J.W. Sherman

Rt 1 Box 697

Bishop, Miss
(mailing address)

WELL LOCATION:

sec. 33 T 6 N R 10 E
Coahuilla
(distance) (direction) (nearest town)

WELL PURPOSE: pond
(home, irrigation, municipal, industrial)

WELL COMPLETION DATA:

- (1) diameter (inches) 4x2"
- (2) total depth (feet) 1392
- (3) static water level (feet) 5 above top of ground
- (4) casing 4x2" (material) 1352 (depth)
4x2" (size) If telescope see back.
- (5) screen 40' (length) 1352 (depth to top)
2" (size) S.S. (material)
- (6) pump (HP) 44 gal (yield gpm)
- (type power)
- (7) electric log no (yes or no)
- (organization running log)

(8) how well bottom plugged 2"
hard well hole

DRILLERS REMARKS:

pond
Very good well

description of formations encountered	from	to
Top Soil	1	5
Red Clay	5	17
White Sand	17	44
Blue Clay	44	315
fine Sand	315	325
Coarse Sand	325	345
hard Blue clay	345	450
fine water Sand	450	475
Coarse Water Sand	475	525
hard Blue clay	525	740
fine Sand	740	750
Coarse Sand	750	814
Blue clay	814	1010
very hard Blue	1010	1250
fine Water Sand	1250	1325
Coarse Water Sand	1325	1392

Very good well
CODED

SEP 15 1971

MISS. BD. OF
WATER COMM.

If well telescopes please sketch and show depths.

GROUND LEVEL

105'

4" casing

1287'

2" glass casing


40'

SS

Screen

2"

baswaka plate

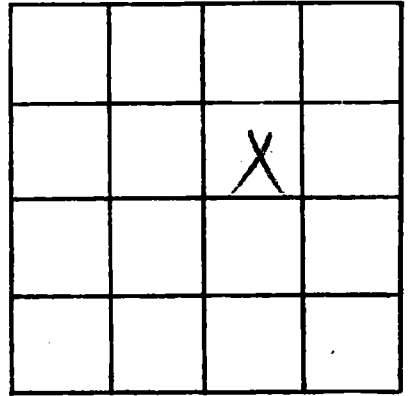

SECTION _____

Please indicate well location X.

ADDITIONAL INFORMATION

very fine well

If more than one screen, show locations of each on sketch.