

HARRISON
H 163
9-1-71

MISSISSIPPI
BOARD OF WATER COMMISSIONERS
416 North State Street
Jackson, Mississippi 39201

WATER WELL DRILLERS LOG

CODED⁷¹

9/1/71 19 Central Drilling Co. Harrison
Date well completed firm name county well located

LANDOWNER: D. Spive
Kt 2
Biloxi, Miss
(mailing address)

description of formations encountered	from	to
	<u>top soil</u>	<u>1</u>
<u>Red pipe Clay</u>	<u>5</u>	<u>17</u>
<u>Blue Clay</u>	<u>17</u>	<u>110</u>
<u>Coarse Sand Part</u>	<u>110</u>	<u>160</u>
<u>Blue Clay</u>	<u>160</u>	<u>240</u>
<u>fine water sand</u>	<u>240</u>	<u>265</u>
<u>clay hard Blue Clay</u>	<u>265</u>	<u>525</u>
<u>fine water sand</u>	<u>525</u>	<u>530</u>
<u>Blue Clay</u>	<u>530</u>	<u>590</u>
<u>fine water sand</u>	<u>590</u>	<u>660</u>
<u>Coarse water sand</u>	<u>660</u>	<u>700</u>

WELL LOCATION:
sec 4 T 6 N R 10 E
S W
3 miles N Cedar Lake
(distance) (direction) (nearest town)

WELL PURPOSE: home
(home, irrigation, municipal, industrial)

WELL COMPLETION DATA:

(1) diameter (inches) 2"

(2) total depth (feet) 700

(3) static water level (feet) 40 below top of ground

(4) casing Galv 690
(material) (depth)

(size) If telescope see back.

(5) screen 10' 690
(length) (depth to top)

2" 55'
(size) (material)

(6) pump one 14
(HP) (yield gpm)

Ele
(type power)

(7) electric log No
(yes or no)

(organization running log)


CODED

(8) how well bottom plugged 2"
flush with water

DRILLERS REMARKS:
None

If well telescopes please sketch and show depths.

GROUND LEVEL

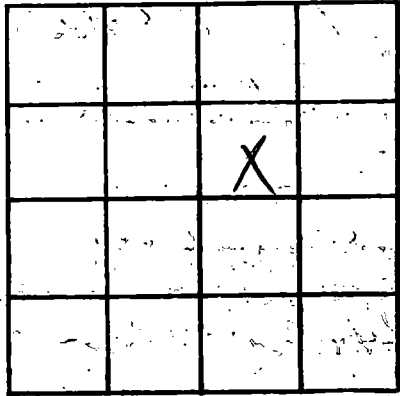

SECTION _____

Please indicate well location X.

ADDITIONAL INFORMATION

If more than one screen, show locations of each on sketch.