

**HARRISON**  
**H 170**  
**12-20-71**

**MISSISSIPPI**  
**BOARD OF WATER COMMISSIONERS**  
 416 North State Street  
 Jackson, Mississippi 39201

**WATER WELL DRILLERS LOG**

Dec 20 71 19 Central Drilling Co. Harrison  
 date well completed firm name county well located

LANDOWNER: Bob Willman  
Rt 1 Box 704  
Biloxi, Miss  
 (mailing address)

WELL LOCATION:  
 sec 22 T 6 N R 10 E  
3 Three miles N Woolmaret  
 (distance) (direction) (nearest town)

WELL PURPOSE: Home  
 (home, irrigation, municipal, industrial)

WELL COMPLETION DATA:  
 (1) diameter (inches) 2"  
 (2) total depth (feet) 498  
 (3) static water level (feet) 90 below  
 top of ground above  
 (4) casing galv, 488,  
 (material) (depth)  
 (size) if telescope see back.  
 (5) screen 10', 488  
 (length) (depth to top)  
2", 55  
 (size) (material)  
 (6) pump one 14  
 (HP) (yield gpm)  
3hp  
 (type power)  
 (7) electric log no  
 (yes or no)  
 (organization running log)

description of formations encountered	from	to
<u>Top Soil</u>	<u>1</u>	<u>3</u>
<u>Red Clay</u>	<u>3</u>	<u>8</u>
<u>White Sand</u>	<u>8</u>	<u>40</u>
<u>Red Clay</u>	<u>40</u>	<u>55</u>
<u>Blue Clay</u>	<u>55</u>	<u>75</u>
<u>Spurs</u>	<u>75</u>	<u>100</u>
<u>Blue Clay</u>	<u>100</u>	<u>340</u>
<u>fine water sand</u>	<u>340</u>	<u>360</u>
<u>Blue Clay</u>	<u>360</u>	<u>420</u>
<u>fine water sand</u>	<u>420</u>	<u>440</u>
<u>Home water sand</u>	<u>440</u>	<u>498</u>


(8) how well bottom plugged 2" fresh wash water  
 DRILLERS REMARKS: None

JAN 10 1972

MISS. BD. OF  
 WATER COMM.

If well telescopes please sketch and show depths.

GROUND LEVEL

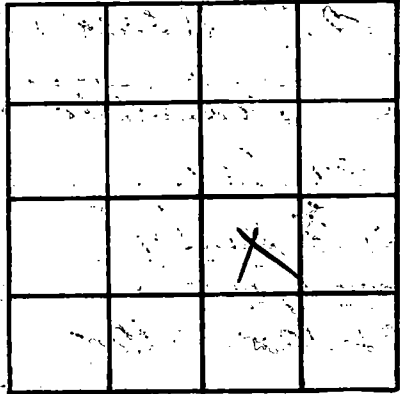

SECTION \_\_\_\_\_

Please indicate well location X.

ADDITIONAL INFORMATION

If more than one screen, show locations of each on sketch.