

**HARRISON**  
**H172**  
**10-19-71**

MISSISSIPPI  
 BOARD OF WATER COMMISSIONERS  
 416 North State Street  
 Jackson, Mississippi 39201

WATER WELL DRILLERS LOG

Oct 19, 71 19 Central Valley Co. Donison  
 Date well completed firm name county well located

LANDOWNER: James H. Linder  
Rt 1 Jim Byrd Rd.  
Biloxi, Miss  
 (mailing address)

WELL LOCATION:  
 sec 34 T 06 S R 10 E W  
2 1/2 miles E of Woodman  
 (distance) (direction) (nearest town)

WELL PURPOSE: Home  
 (home, irrigation, municipal, industrial)

WELL COMPLETION DATA:

(1) diameter (inches) 2"

(2) total depth (feet) 435

(3) static water level (feet) 15 below top of ground

(4) casing Galv. 425  
 (material) (depth)

\_\_\_\_\_ if telescope see back.  
 (size)

(5) screen 10' 425  
 (length) (depth to top)

2" SS  
 (size) (material)

(6) pump 1/2 14  
 (HP) (yield gpm)

Elec  
 (type power)

(7) electric log No  
 (yes or no)

\_\_\_\_\_ (organization running log)

(8) how well bottom plugged 2" backwash valve

description of formations encountered	from	to
<u>Top Soil</u>	<u>1</u>	<u>3</u>
<u>Red Clay</u>	<u>3</u>	<u>9</u>
<u>White Sand</u>	<u>9</u>	<u>48</u>
<u>Flint</u>	<u>48</u>	<u>60</u>
<u>Red Clay</u>	<u>60</u>	<u>75</u>
<u>Blue Clay</u>	<u>75</u>	<u>200</u>
<u>White Sand</u>	<u>200</u>	<u>220</u>
<u>Blue Clay</u>	<u>220</u>	<u>400</u>
<u>Coarse Blue Sand</u>	<u>400</u>	<u>435</u>


DRILLERS REMARKS:  
None

JAN 10 1972

MISS. Bd. of  
 WATER COMMISSIONERS

If well telescopes please sketch and show depths.

GROUND LEVEL

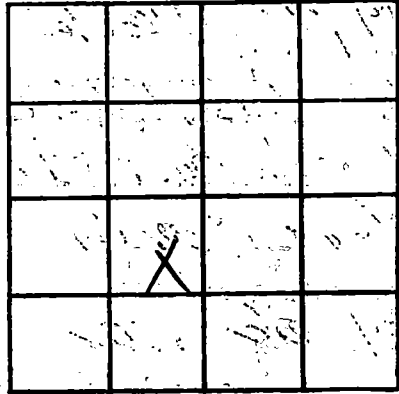

SECTION \_\_\_\_\_

Please indicate well location X.

**ADDITIONAL INFORMATION**

If more than one screen, show locations of each on sketch.