

**HARRISON**  
**H 178**  
**1-7-72**

MISSISSIPPI  
 BOARD OF WATER COMMISSIONERS  
 416 North State Street  
 Jackson, Mississippi 39201


WATER WELL DRILLERS LOG

Jan. 7 19 72 McNeil Well Works Harrison  
 date well completed firm name county well located

LANDOWNER:	description of formations encountered	from	to
Red Cross			
P.O. Box 164. P.O. (mailing address)	clay	0	87
WELL LOCATION:	sand	87	98
sec. <u>28</u> T. <u>6</u> N. R. <u>9</u> E.	clay	98	282
<u>18</u> miles <u>NE</u> of <u>Bilbo</u> (distance) (direction) (nearest town)	fine sand	282	346
WELL PURPOSE: <u>Home</u> (home, irrigation, municipal, industrial)	course sand	346	432
WELL COMPLETION DATA:			
(1) diameter (inches) <u>2"</u>			
(2) total depth (feet) <u>432'</u>			
(3) static water level (feet) <u>47'</u> below top of ground. above			
(4) casing <u>gal.</u> <u>422'</u> (material) (depth)			
(size) If telescope see back.			
(5) screen <u>10'</u> (length) (depth to top)			
<u>2"</u> (size) <u>35.</u> (material)			
(6) pump <u>1</u> (HP) <u>6</u> (yield gpm)			
<u>Electric</u> (type power)			
(7) electric log <u>NO</u> (yes or no)			
<u>NO</u> (organization running log)			
(8) how well bottom plugged <u>sand</u> <u>mark</u>			
DRILLERS REMARKS:			

If well telescopes please  
sketch and show depths.

GROUND LEVEL

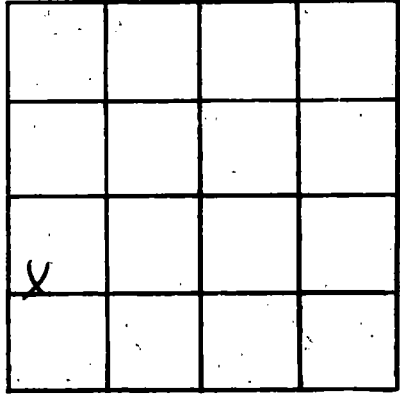

SECTION 28

Please indicate well location X.

ADDITIONAL INFORMATION

If more than one screen,  
show locations of each on sketch.