

HARRISON
H 188
3-19-73

MISSISSIPPI
 BOARD OF WATER COMMISSIONERS
 416 North State Street
 Jackson, Mississippi 39201

CODED

WATER WELL DRILLERS LOG

3-19 1973 Swidys Well Company Harrison
 date well completed firm name county well located

LANDOWNER Vernon Williams

description of formations encountered	from	to
	0	28
clay	28	40
sand	40	46
mud	46	100
clay	100	120
sand, fine	120	140
sand, fair red	140	269
clay	269	277
mud	277	279
sand	279	299
sand, fair	299	315
sand, good		

(mailing address)

WELL LOCATION:

sec. 24 T. 6 S. R. 10 E. W.
6 miles SW of Rt 1
 (distance) (direction) (nearest town)

WELL PURPOSE: home
 (home, irrigation, municipal, industrial)

WELL COMPLETION DATA:


- (1) diameter (inches) 2"
- (2) total depth (feet) 315'
- (3) static water level (feet) 61 ^{below} ~~above~~ top of ground.
- (4) casing galv. 315'
 (material) (depth)
 (size) If telescope see back.
- (5) screen 10' 305'
 (length) (depth to top)
008 stainless steel
 (size) (material)
- (6) pump 1/2 7
 (HP) (yield gpm)
 (type power)
- (7) electric log no (yes or no)
 (organization running log)
- (8) how well bottom plugged Mark
pressure valve

CODED

DRILLERS REMARKS:

If well telescopes please sketch and show depths.

GROUND LEVEL

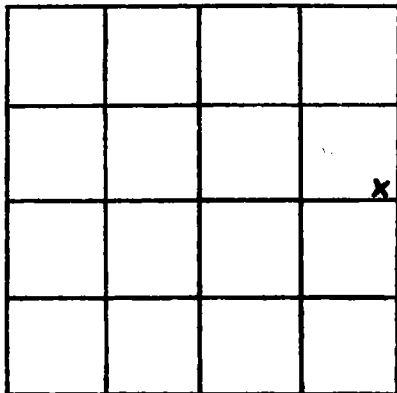

SECTION 24

Please indicate well location X.

ADDITIONAL INFORMATION

If more than one screen, show locations of each on sketch.