

HARRISON
H 189
10-28-71

MISSISSIPPI
 BOARD OF WATER COMMISSIONERS
 416 North State Street
 Jackson, Mississippi 39201

CODED

WATER WELL DRILLERS LOG

Oct 28 19 71 McGill wellworks Harrison
 date well completed firm name county well located

LANDOWNER: J. Albert & Mary
Chesto
 Rt. 3 Box 263B Cook Rd.
Silopi, Miss.
 (mailing address)

description of formations encountered	from	to
clay	0	16
concrete pad	16	55
blue clay	55	172
slush	172	247
blue clay	247	388
fine sand	388	392
concrete pad	392	400

WELL LOCATION:
 sec 336 N R 9 E
6 1/2 miles NW of D. Sherville
 (distance) (direction) (nearest town)

WELL PURPOSE: home
 (home, irrigation, municipal, industrial)

- WELL COMPLETION DATA:
- (1) diameter (inches) 2"
 - (2) total depth (feet) 400'
 - (3) static water level (feet) 51' below above top of ground.
 - (4) casing gal. 390
 (material) (depth)
 (size) if telescope see back.
 - (5) screen 10'
 (length) (depth to top)
2" 5.5
 (size) (material)
 - (6) pump 1 7
 (HP) (yield gpm)
electric
 (type power)
 - (7) electric log no
 (yes or no)
 - (organization running log)
 - (8) how well bottom plugged hard
short

WARRANTY


MAY 29 1973

DRILLERS REMARKS:

MISS. BOARD OF WATER COMMISSIONERS

If well telescopes please sketch and show depths.

GROUND LEVEL

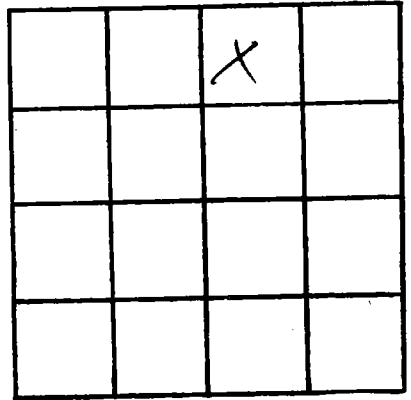

SECTION 33

Please indicate well location X.

ADDITIONAL INFORMATION

If more than one screen,
show locations of each on sketch.