

HARRISON
H 190
3-11-72

MISSISSIPPI
 BOARD OF WATER COMMISSIONERS
 416 North State Street
 Jackson, Mississippi 39201

CODED

WATER WELL DRILLERS LOG

march 11 19 72 McGilwell works Harrison
 date well completed firm name county well located

LANDOWNER: Roelen Dalgo
Biloxi, miss

(mailing address)

WELL LOCATION:

sec 5 T 6 N R 9 E
22 1/2 miles N.E. of Biloxi
 (distance) (direction) (nearest town)

WELL PURPOSE:

Home
 (home, irrigation, municipal, industrial)

WELL COMPLETION DATA:

- (1) diameter (inches) 2"
- (2) total depth (feet) 482
- (3) static water level (feet) 47' below above top of ground.
- (4) casing gal. 472'
 (material) (depth)
 if telescope see back.
 (size)
- (5) screen 10'
 (length) (depth to top)
2" 5.5
 (size) (material)
- (6) pump 1 7
 (HP) (yield gpm)
Electric
 (type power)
- (7) electric log no
 (yes or no)

 (organization running log)
- (8) how well bottom plugged Sand
Shank

description of formations encountered	from	to
clay	0	52
coarse sand	52	67
blue clay	67	111
slush	111	141
fine sand	141	162
blue clay	162	214
slush	214	231
white clay	231	289
slush	289	313
white clay	313	344
fine sand	344	377
blue clay	377	429
fine sand	429	451
coarse sand	451	492


CODED

MAY 29 1973

DRILLERS REMARKS:

If well telescopes please sketch and show depths.

GROUND LEVEL

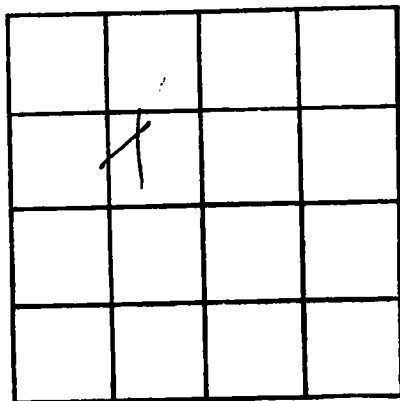

SECTION 5

Please indicate well location X.

ADDITIONAL INFORMATION

If more than one screen, show locations of each on sketch.