

HARRISON
H 191
7-23-73

MISSISSIPPI
BOARD OF WATER COMMISSIONERS
416 North State Street
Jackson, Mississippi 39201

CODEC

WATER WELL DRILLERS LOG

Aug 24 1973 McGill well works Harrison
date well completed firm name county well located

LANDOWNER: <u>Log. Morris Barber</u>	description of formations encountered	from	to
<u>Biloxi, Miss.</u>			
(mailing address)	<u>clay</u>	<u>0</u>	<u>18</u>
	<u>coral sand</u>	<u>18</u>	<u>57</u>
	<u>clay</u>	<u>57</u>	<u>132</u>
	<u>sand</u>	<u>132</u>	<u>168</u>

WELL LOCATION:
sec. 24 T. 6 N. R. 10 E.
16 1/2 miles S N.W. of Biloxi
(distance) (direction) (nearest town)

WELL PURPOSE: Private
(home, irrigation, municipal, industrial)

- WELL COMPLETION DATA:
- (1) diameter (inches) 2"
 - (2) total depth (feet) 169'
 - (3) static water level (feet) 28' below top of ground.
 - (4) casing gal 149'
(material) (depth)
 - If telescope see back.
(size)
 - (5) screen 20' 3'
(length) (depth to top)
 - 2" 3.5
(size) (material)
 - (6) pump 1 3
(HP) (yield gpm)
 - Electric
(type power)
 - (7) electric log NO
(yes or no)
 - (organization running log)
 - (8) how well bottom plugged Sand
shark


CODEC

DRILLERS REMARKS: well did not produce right so we pulled up and reformed dash in fuel

JUN 13 1973

If well telescopes please sketch and show depths.

GROUND LEVEL

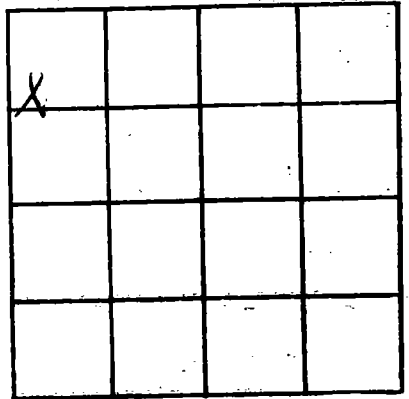

SECTION 24

Please indicate well location X.

ADDITIONAL INFORMATION

If more than one screen, show locations of each on sketch.