

Harrison
H 195
5-28-73

MISSISSIPPI
BOARD OF WATER COMMISSIONERS
416 North State Street
Jackson, Mississippi 39201

CODED

WATER WELL DRILLERS LOG
COASTAL DRILLING & SERVICE CO.
ROUTE 1 ^{Box} 618

Harrison
county well located

5728 19 73
date well completed

LANDOWNER: Jim Rehberger
Rt 1
Biloxi, Miss
(mailing address)

Description of formations encountered	39532	
	from	to
<u>Top Soil</u>	<u>1</u>	<u>2</u>
<u>Red Sand</u>	<u>2</u>	<u>27</u>
<u>White Sand</u>	<u>27</u>	<u>55</u>
<u>Blue Calc. Clay</u>	<u>55</u>	<u>245</u>
<u>fine white sand</u>	<u>245</u>	<u>255</u>
<u>Coarse water sand</u>	<u>255</u>	<u>286</u>

WELL LOCATION:
sec 32 T 6 N R 10 E
Woodcrest
(distance) (direction) (nearest town)

WELL PURPOSE: Home
(home, irrigation, municipal, industrial)

- WELL COMPLETION DATA:
- (1) diameter (inches) 2"
 - (2) total depth (feet) 286
 - (3) static water level (feet) 3 below above top of ground.
 - (4) casing Galv 276
(material) (depth)
 - (5) screen 10' 276
(length) (depth to top)
2" SS
(size) (material)
 - (6) pump 1/2 23
(HP) (yield gpm)
Ele
(type power)
 - (7) electric log No
(yes or no)
- (organization running log)

CODED

(8) how well bottom plugged
2" black wash valve


SEP 7 1973

DRILLERS REMARKS:
Very good well

MISS. BD. OF
WATER COMM.

If well telescopes please sketch and show depths.

GROUND LEVEL

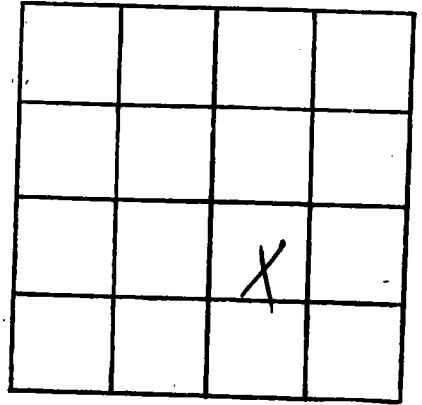

SECTION _____

Please indicate well location X.

ADDITIONAL INFORMATION

If more than one screen,
show locations of each on sketch.