

Harrison
 H 197
 8-3-73

MISSISSIPPI
 BOARD OF WATER COMMISSIONERS
 416 North State Street
 Jackson, Mississippi 39201

CODED

WATER WELL DRILLERS LOG

Harrison
 county well located

8/3 1973 COASTAL DRILLING & SERVICE CO.
 date well completed firm name

ROUTE 1 BOX 618

LANDOWNER: Mrs. ~~Harold~~ ~~W. H. H. H.~~
 DECAT, MISS.

depth of formations
 3932 countered

from to

Rt 1 Box 790
 Bilani, Miss
 (mailing address)

Top Soil	1	4
Red Clay	4	14
White Sand	14	37
Sugary Sand	37	60
White Sand	60	85
Soft Blue Clay	85	210
Hard Blue Clay	210	460
fine water Sand	460	470
Coarse water Sand	470	520

WELL LOCATION:

sec 27 T 6 S R 10 E
 2 1/2 miles NW Coahoma
 (distance) (direction) (nearest town)

WELL PURPOSE: Home
 (home, irrigation, municipal, industrial)

WELL COMPLETION DATA:

- (1) diameter (inches) 2"
- (2) total depth (feet) 520'
- (3) static water level (feet) 82 below top of ground
- (4) casing glass 510' (material) (depth)
- (5) screen 10' 510' (length) (depth to top)
 2" (size) (material)
- (6) pump 1 HP 10 (HP) (yield gpm)
 Ele (type power)
- (7) electric log no (yes or no)

CODED

(organization running log)

(8) how well bottom plugged
 2" back wash valve

DRILLERS REMARKS:


good well

SEP 7 1973

MISS. BD. OF
 WATER COMM.

If well telescopes please sketch and show depths.

GROUND LEVEL

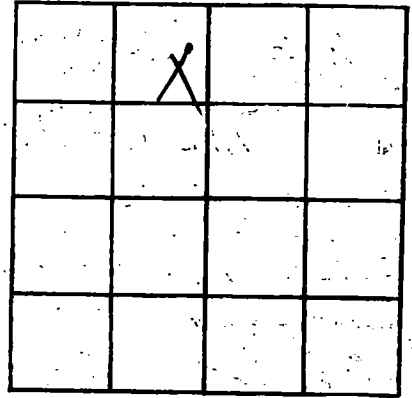

SECTION _____

Please indicate well location X.

ADDITIONAL INFORMATION

If more than one screen,
show locations of each on sketch.