

Harrison
H201
6-11-73

MISSISSIPPI
BOARD OF WATER COMMISSIONERS
416 North State Street
Jackson, Mississippi 39201

CODED

WATER WELL DRILLERS LOG
COASTAL DRILLING & SERVICE CO.

10/11
date well completed

1973
ROUTE 1 BURMISTONE

Harrison
county well located

LANDOWNER: BILOXI, MISS. 89532

description of formations encountered

from to

B. Stanley
Rt 1 Belvoir, Miss
(mailing address)

Top Soil	1	2
Loch	2	3
Red Clay	3	14
White Sand	14	40
Sugar Sand	40	65
Soft Blue Clay	65	150
Hard Blue Clay	150	380
fine water sand	380	420
Coarse water sand	420	460

WELL LOCATION:

sec 23 T 6 S R 10 E
(3) Three miles (distance) NW (direction) of (3) Three miles (distance) of (3) Three miles (distance) (nearest town)

WELL PURPOSE: home
(home, irrigation, municipal, industrial)

WELL COMPLETION DATA:

- (1) diameter (inches) 2"
- (2) total depth (feet) 460
- (3) static water level (feet) 80 below top of ground
- (4) casing (material) gal (depth) 450'
- (5) screen (size) 10' (length) 450' (depth to top) 2" (size) S.S. (material)
- (6) pump One (HP) 12 (yield gpm)
- (7) electric log No (yes or no)

CODED

(organization running log)

(8) how well bottom plugged 2" hard packed gravel

SEP 7 1973

DRILLERS REMARKS:


None

MISS. Bd. OE

WATER LOGS

If well telescopes please sketch and show depths.

GROUND LEVEL

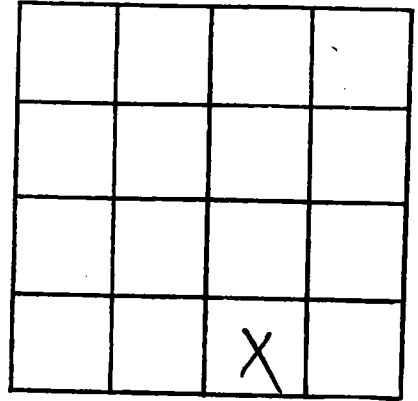

SECTION _____

Please indicate well location X.

ADDITIONAL INFORMATION

If more than one screen,
show locations of each on sketch.