

H 208
 HARRISON
 4-22-74

MISSISSIPPI
 BOARD OF WATER COMMISSIONERS
 416 North State Street
 Jackson, Mississippi 39201
 WATER WELL DRILLERS LOG

4-22-74 19 1974 P. J. Moore HARRISON
 date well completed firm name county well located

LANDOWNER: J. D. HENRICH
RT #3 GULFPORT
 (mailing address)
 WELL LOCATION:
 sec. 31 T. 6 N. R. 10 E.
2 miles E of NIUSANT
 (distance) (direction) (nearest town)

| description of formations encountered | from | to |
|---------------------------------------|------|-----|
| TOP SOIL | 0 | 10 |
| White TOP SOIL | 10 | 25 |
| white + blue clay | 25 | 70 |
| Grey clay | 70 | 120 |
| SILT SAND | 120 | 140 |
| Blue clay | 140 | 250 |
| Med grey SAND | 250 | 270 |

WELL PURPOSE:
 (home, irrigation, municipal, industrial)

WELL COMPLETION DATA:
 (1) diameter (inches) 2"
 (2) total depth (feet) 270'
 (3) static water level (feet) 40' ^{below} _{above} top of ground.
 (4) casing 9441 260'
 (material) (depth)
 _____ if telescope see back.
 (size)
 (5) screen 10' 260'
 (length) (depth to top)
2" SS
 (size) (material)
 (6) pump 1 8
 (HP) (yield gpm)
8
 (type power)
 (7) electric log _____
 (yes or no)


 (organization running log)
 (8) how well bottom plugged
Not plugged

CODED

DRILLERS REMARKS:

If well telescopes please sketch and show depths.

GROUND LEVEL

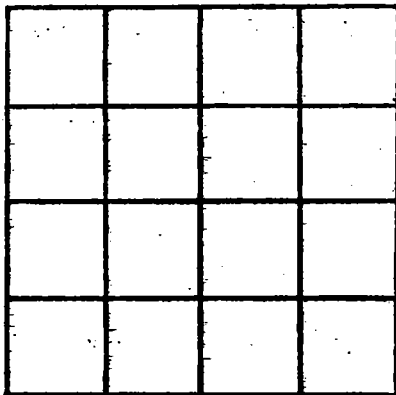

SECTION _____

Please indicate well location X.

ADDITIONAL INFORMATION

If more than one screen, show locations of each on sketch.