

HARRISON
H 211
6-7-74

MISSISSIPPI **CODED**
 BOARD OF WATER COMMISSIONERS
 416 North State Street
 Jackson, Mississippi 39201

WATER WELL DRILLERS LOG

6-7-74 19 74
 date well completed

P. J. Moore
 firm name

HARRISON
 county well located

LANDOWNER: D. MARIE
Box 3 Biloxi River Estate
Gulfport, MS
 (mailing address)

WELL LOCATION:
 sec. 31 T. 6 N. R. 10 E.
4 miles E of MOZENT
 (distance) (direction) (nearest town)

WELL PURPOSE:
 (Home, Irrigation, municipal, Industrial)

WELL COMPLETION DATA:

(1) diameter (inches) 2"

(2) total depth (feet) 300'

(3) static water level (feet) 25' (below top of ground)

(4) casing PVC 290'
 (material) (depth)

(size) if telescope see back.

(5) screen 10' 290'
 (length) (depth to top)

2" PVC
 (size) (material)

(6) pump 1 10
 (HP) (yield gpm)

E
 (type power)

(7) electric log (yes or no) _____

(organization running log) _____

(8) how well bottom plugged Plugged


description of formations encountered	from	to
TOP SOIL	0	10
WHITE CLAY	10	40
RED SAND	40	50
BLUE CLAY	50	135
FINE SILTY SAND	135	160
BLUE CLAY	160	190
FINE SAND	190	200
BLUE CLAY	200	275
COURSE GRAY SAND	275	300

DRILLERS REMARKS:

If well telescopes please sketch and show depths.

GROUND LEVEL

100
90
80
70
60
50
40
30
20
10
0
-10
-20
-30
-40
-50
-60
-70
-80
-90
-100

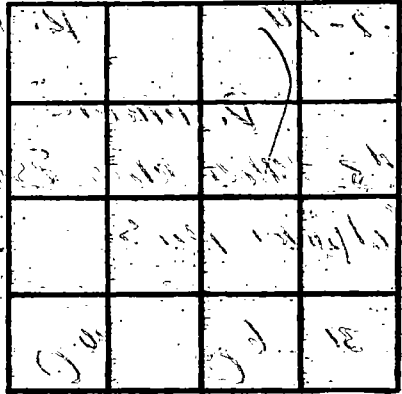

SECTION _____

Please indicate well location X.

ADDITIONAL INFORMATION

If more than one screen, show locations of each on sketch.