

HARRISON
H 214
2-21-74

MISSISSIPPI
BOARD OF WATER COMMISSIONERS
416 North State Street
Jackson, Mississippi 39201

CODED

WATER WELL DRILLERS LOG

2/21 1974 COASTAL DRILLING & SERVICE CO. *Harrison*
date well completed firm name county well located
ROUTE 1 BOX 618

LANDOWNER: *Dr Jee* BILOXI, MISS
Rt 1 Box 736
Biloxi, Miss
(mailing address)

Description of formations encountered	from	to
<i>Top Soil</i>	<i>1</i>	<i>2</i>
<i>Red Sand</i>	<i>2</i>	<i>15</i>
<i>Super Sand</i>	<i>15</i>	<i>30</i>
<i>Soft Blue Clay</i>	<i>30</i>	<i>200</i>
<i>Hard Blue Clay</i>	<i>200</i>	<i>230</i>
<i>fine water sand</i>	<i>230</i>	<i>240</i>
<i>Hard Blue Clay</i>	<i>240</i>	<i>260</i>
<i>fine water sand</i>	<i>260</i>	<i>280</i>

WELL LOCATION:
sec *32* T *6N* R *10E*
Woodmoor
W
(distance) (direction) (nearest town)

WELL PURPOSE: *Home*
(home, irrigation, municipal, industrial)

WELL COMPLETION DATA:

- (1) diameter (inches) 2"
- (2) total depth (feet) 280'
- (3) static water level (feet) 18 below above top of ground.
- (4) casing PVC 270'
(material) (depth)
- (size) if telescope see back.
- (5) screen 10' 270'
(length) (depth to top)
- 2" PVC
(size) (material)
- (6) pump 1/2 15
(HP) (yield gpm)
- Ele
(type power)
- (7) electric log no
(yes or no)
- (organization running log)

CODED


(8) How well bottom plugged 2"
hard wash valve

DRILLERS REMARKS:

RECORDED
INDEXED
MAY 15 1974

If well telescopes please sketch and show depths.

GROUND LEVEL

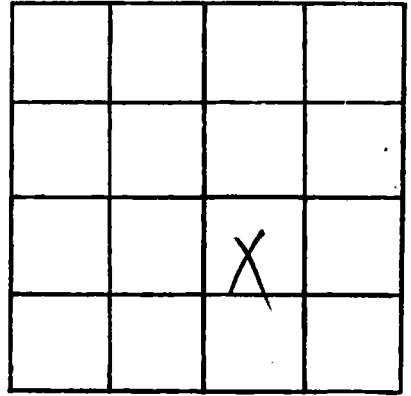

SECTION _____

Please indicate well location X.

ADDITIONAL INFORMATION

If more than one screen,
show locations of each on sketch.