

Harrison
H 217
3-1-74

MISSISSIPPI
 BOARD OF WATER COMMISSIONERS
 416 North State Street
 Jackson, Mississippi 39201

WATER WELL DRILLERS LOG

CODED

2-1-74 19
 date well completed

Mc Gill Well Works
 firm name

Harrison
 county well located

LANDOWNER: George Fountain
 Rt. 5, Box 597
 Sulphur, Miss.
 (mailing address)

WELL LOCATION:
 sec. 36 T. 4 N. R. 10 E.
 9 miles NE of Sulphur
 (distance) (direction) (nearest town)

WELL PURPOSE: Home
 (home, irrigation, municipal, industrial)

WELL COMPLETION DATA:

(1) diameter (inches) 2"

(2) total depth (feet) 678'

(3) static water level (feet) 14' ^{below} top of ground.

(4) casing P.V.C., 668'
 (material) (depth)

(5) screen 10' (length) (depth to top)
 2" (size) 3.5 (material)

(6) pump 1 (HP) 12 (yield gpm)
 electric (type power)

(7) electric log (yes or no)

(8) how well bottom plugged and sealed
 back wash valve

description of formations encountered	from	to
clay	0	20
Blue mud	20	97
slush	97	131
fine sand	131	172
Blue clay	172	208
slush	208	260
Blue mud	260	314
fine sand	314	369
Blue mud	369	428
slush	428	481
fine sand	481	525
Blue mud	525	571
slush	571	618
course sand	618	678


DRILLERS REMARKS:

RECEIVED

OCT 20 1974

If well telescopes please sketch and show depths.

GROUND LEVEL

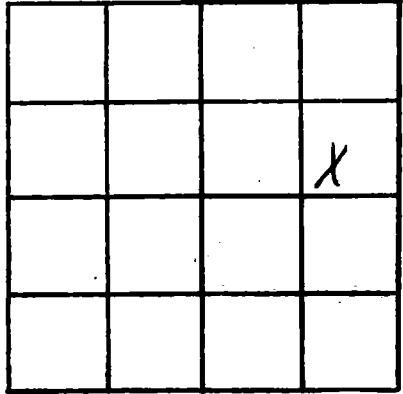

SECTION

36

Please indicate well location X.

ADDITIONAL INFORMATION

If more than one screen, show locations of each on sketch.