

HARRISON
H 221
1-30-75

MISSISSIPPI
BOARD OF WATER COMMISSIONERS
416 North State Street
Jackson, Mississippi 39201

CODED
CODED

WATER WELL DRILLERS LOG

30 JAN 75 19 Bayant Well Co HARRISON
date well completed firm name county well located

LANDOWNER: Bill Morgan
RT 2 Box 504-A
Box Ms. 39532
(mailing address)

WELL LOCATION:
sec 23 T 6 S R 10 W
6 miles N of Biloxi
(distance) (direction) (nearest town)

WELL PURPOSE: HOME
(home, irrigation, municipal, industrial)

WELL COMPLETION DATA:

(1) diameter (inches) 2

(2) total depth (feet) 297

(3) static water level (feet) 17 below
top of ground.

(4) casing Galv 333
(material) (depth)

— If telescope see back.
(size)

(5) screen 10' 333
(length) (depth to top)

2 s/s
(size) (material)

(6) pump 1 10
(HP) (yield gpm)

ELECT
(type power)

(7) electric log No
(yes or no)

—
(organization running log)


(8) how well bottom plugged Metal
BACK PIPE W/ 2 YARDS

description of formations encountered	from	to
clay	0	6
sand	6	83
clay	83	105
sand	105	109
sandy clay	109	170
sand	170	175
clay	175	297
GOOD OBERIN	297	343

DRILLERS REMARKS:
FEB 24

If well telescopes please sketch and show depths.

GROUND LEVEL

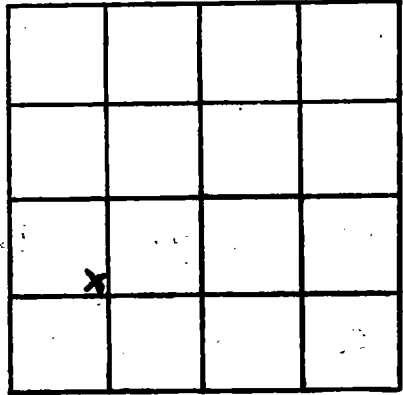

SECTION 23

Please indicate well location X.

ADDITIONAL INFORMATION

If more than one screen,
show locations of each on sketch.